CI / CI

IREDELL COUNTY HEALTH DEPARTMENT

STATESVILLE 704-878-5305 MOORESVILLE 704-664-5281

IMPROVEMENT PERMIT / AUTHORIZATION TO CONSTRUCT / OPERATION PERMIT / EXISTING SYSTEM INSPECTION

PERMIT# 103153 PIN# 4723-26-9505 DATE 11-6-01

OWNER OR CONTRACTOR JEFF & KAREN THOMAS PHONE: Business 704-872-9508 Home

ADDRESS 224 SIGNAL HILL DRIVE STATESVILLE NC 28625

LOCATION BUFFALO SHOALS (R) AIRPORT, (L) SANDTRAP, 7/10 mile on LEFT PAST 2nd HOUSE ON LEFT

SUBDIVISION Britton Hills BLOCK / SECTION LOT 13 LOT AREA .75 AC SITE CLASS PS DESIGN FLOW 360 L.T.A.R. 1.5

Septic Tank: 1000 Gallons; STB 760 Date 11-1-01
Pump Tank: Gallons; PT Date
Pump Make: Model Serial No.
Nitrification Field: No Fields 1 Square Feet 1200' Linear Feet 400'
No Lines 4x100' Trench Width 36" Max Trench Bottom Depth 30" Gravel Depth 12"

[X] New System [ ] Repair System Type: I (II) III. IV. V. VI
System Description: CONV GRAV
Repair System Description: GRAY PANEL / 25% REDUCT
Maintenance Agreement Required: [ ] Yes [X] No
[ ] Slab [X] Crawl Space [ ] Basement w/plumbing [ ] Basement wo/plumbing


[X] House/Mod. Home No. Bedrooms 3
[ ] Mobile Home No. Bathrooms 2
[ ] Business No. Employees
[ ] Other

Water Supply: [ ] Individual [X] Public [ ] Community


Comments:/Conditions: (1) CALL PRIOR TO INSTALLATION FOR FLAGOUT
(2) MAINTAIN SETBACKS (3) INSTALL CLEAN OUTLETS

Comments:/Conditions: ZABEL FILTER & MARKER

INITIAL SITE SKETCH 1" = 50'

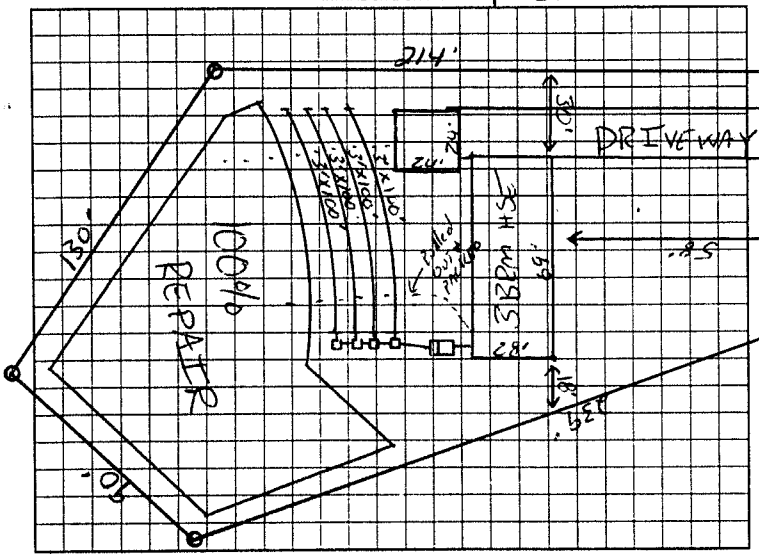

AS BUILT SKETCH

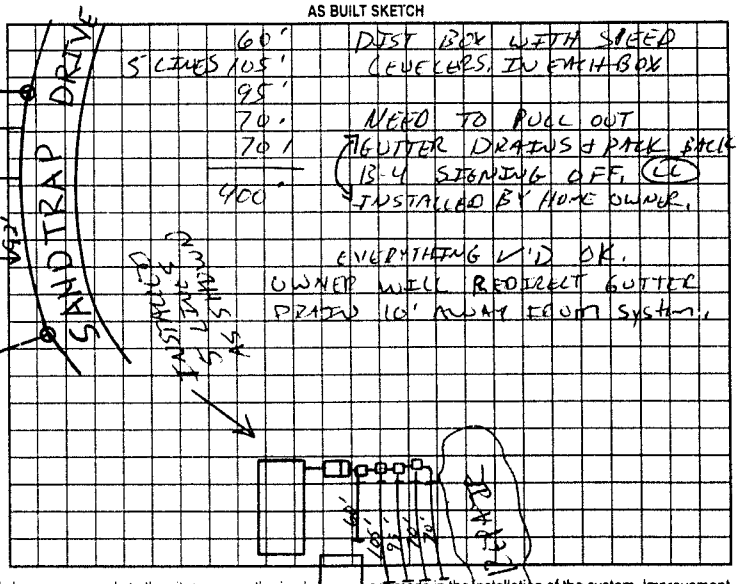

Permit can be suspended or revoked if any false information is supplied toward securing the permit/any unauthorized changes are made to the site/any unauthorized changes are made in the installation of the system. Improvement Permit with plat valid without expiration. Improvement Permit with site plan valid for sixty months. Authorization to Construct is valid for a period equal to that of Improvement Permit – not to exceed sixty months.

Signed: Jeffrey K Thomas date 11/6/01
Improvement Permit by: [signature] date 11-6-01
Authorization to Construct by: [signature] RS date 11-6-01

Installed by: RICK MILLER
Operation Permit by: Jim Cook RS date 04-19-02
Existing System Inspection by: date

HEALTH DEPT. COPY: WHITE OWNER COPY (FINAL): YELLOW OWNER COPY (INITIAL): PINK