IREDELL COUNTY HEALTH DEPARTMENT

STATESVILLE 704-878-5305 MOORESVILLE 704-664-5281

IMPROVEMENT PERMIT / AUTHORIZATION TO CONSTRUCT / OPERATION PERMIT / EXISTING SYSTEM INSPECTION

PERMIT# 152737 PIN# 4723 27 8019 DATE 10-9-08

OWNER OR APPLICANT Wilson Building Inc PHONE: Business 704-902-4441 Home 704-880-8219 cmdy

ADDRESS 120 White Dogwood Statesville NC 28625

LOCATION Hoffman Shops @ Airport @ Sandtrap on pt

SUBDIVISION Britton Hills BLOCK / SECTION ___ LOT 30 LOT AREA 1.0 Ac SITE CLASS. PS DESIGN FLOW 360 L.T.A.R. 13

Septic Tank: 1000 Gallons: STB ~~1000~~ 1000 Date 2-27-08

Pump Tank: ___ Gallons: PT ___ Date ___

Pump Make: ___ Model ___ Serial No. ___

Nitrification Field: No Fields 1 Square Feet ER=1200' Linear Feet 300'

No Lines 3X100' Trench Width 36" Max Trench Bottom Depth 36"

☒ New System ☐ Repair ☐ Expansion System Type: I II III IV V VI

System Description: Gravity 250/1 Bedroom

Repair System Description: 40 50% Reduction

Maintenance Agreement Required: ☐ Yes ☒ No

☒ House/Mod. Home ☐ Mobile Home ☐ Business ☐ Other

No. Bedrooms 3 No. Persons 4 No. Employees ___

Water Supply: ☐ Individual ☒ Public ☐ Community

Gravel Depth N/A ☒ Gravity ☐ Pressure ☐ Slab ☒ Crawl Space ☐ Basement w/plumbing ☐ Basement wo/plumbing

Comments/Conditions: (1) DO NOT INSTALL Driveway Until Septic Lines Are ~~cover~~ Installed. Driveway cannot be over drainlines; (2) House Staked & system flagged out completely. P/L MBD MARKED; (3) Install lines on

Comments/Conditions: contours & maintain setbacks, (4) See comments on permit drawing

INITIAL SITE SKETCH

SEE ATTACHED SYSTEM DESIGN BY LOWE GOOK, R.S.I

MFG-10/12 MFG DATE 2-27-08

AS BUILT SKETCH

POLYLOK Filter & MARKER, SYSTEM INSTALLED 10' OFF MARKED P/L. Driveway NOT POURED AT TIME OF CHECK.

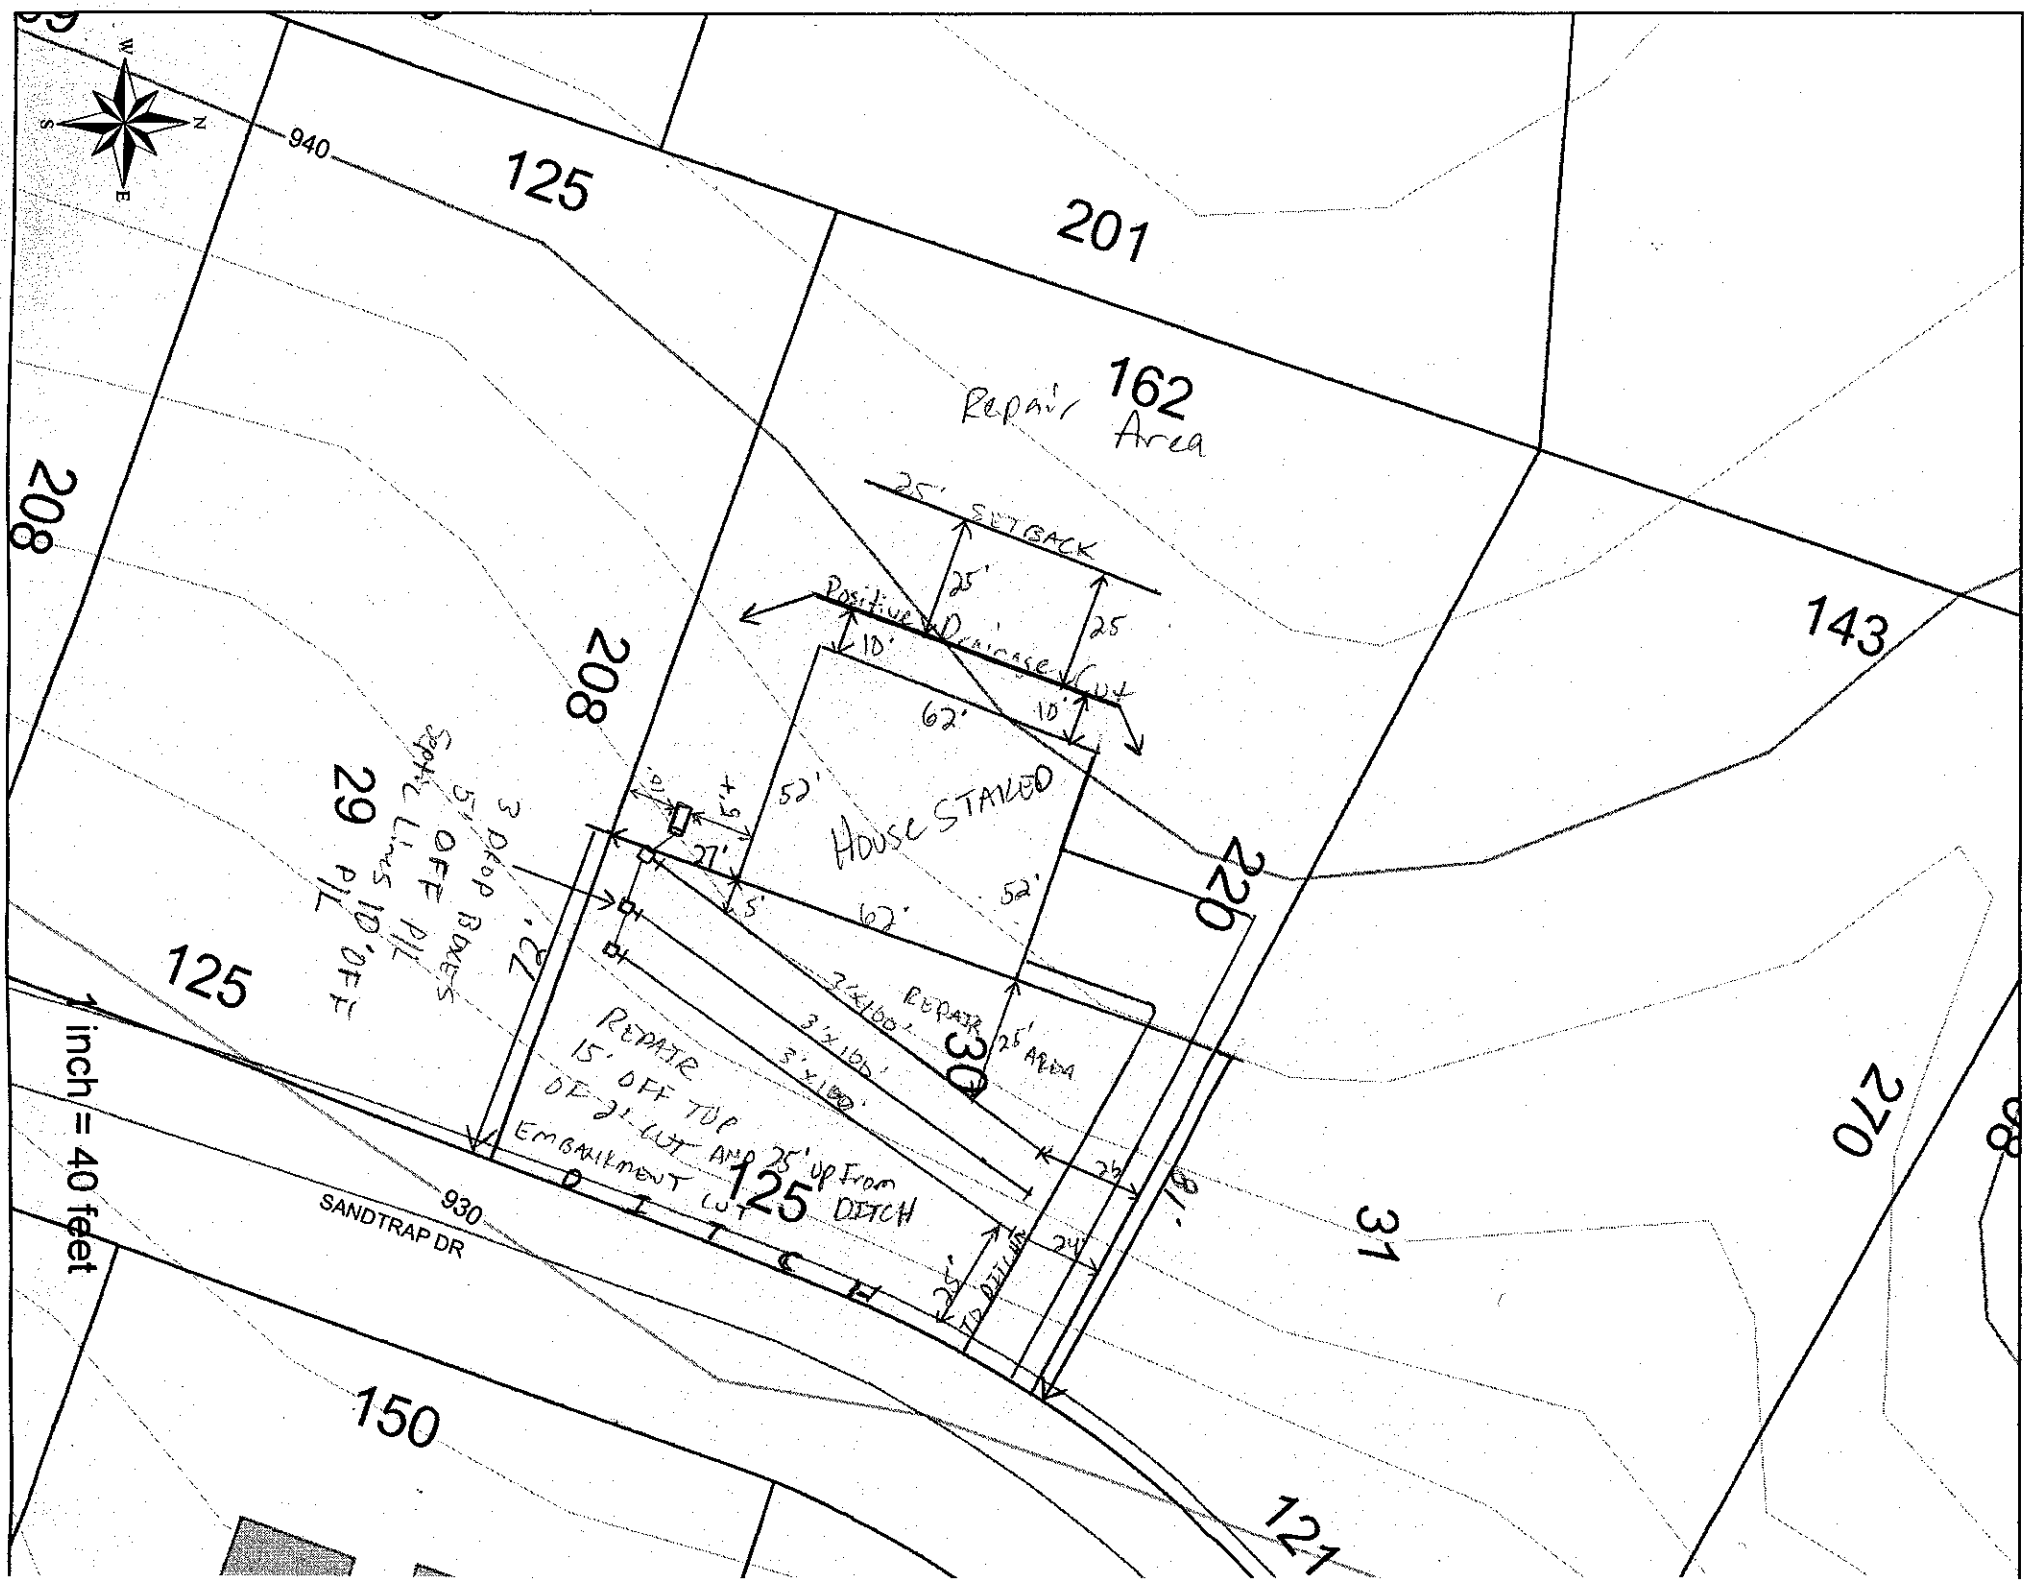
Permit can be suspended or revoked if any false information is supplied toward securing the permit/any unauthorized changes are made to the site/any unauthorized changes are made in the installation of the system. Improvement Permit with plan valid without expiration ☐ Improvement Permit with site plan valid for sixty months ☒ Authorization to Construct is valid for a period equal to that of Improvement Permit – not to exceed sixty months.

Signed: [signature] date 10-10-08 Installed by: Craig Thompson Grading

Improvement Permit by: [signature] RS date 10-9-08 Operation Permit by: [signature] RS date 2-12-09

Authorization to Construct by: [signature] RS date 10-9-08 Existing System Inspection by: ___ date ___

HEALTH DEPT. COPY: WHITE OWNER COPY (FINAL): YELLOW OWNER COPY (INITIAL): PINK


940
125
201
162
Repair Area
208
208
143
220
270
31
125
125
150
121
930
SANDTRAP DR
25' SETBACK
25'
25
Positive Drainage Cut
10'
10'
62'
HOUSE STAKED
52'
52'
62'
72'
27'
5'
5'x5'
10'
29
30
REPAIR
25' AREA
REPAIR
15' OFF TOP AND 25' UP From DITCH
OF 2:1 CUT
EMBANKMENT CUT
25'
24'
25' TO DITCH
1 inch = 40 feet