IREDELL COUNTY HEALTH DEPARTMENT

STATESVILLE 704-878-5305 (C1) MOORESVILLE 704-664-5281

IMPROVEMENT PERMIT / AUTHORIZATION TO CONSTRUCT / OPERATION PERMIT / EXISTING SYSTEM INSPECTION

(1)

PERMIT# 103607 PIN# 4723-37-2149 DATE 12-17-01

OWNER OR CONTRACTOR BRAD MOFFITT PHONE: Business Home (704) 902-2828

ADDRESS 120 SHALOM PLACE, STATESVILLE, NC 28677

LOCATION US 70 WEST, TL AIRPORT ROAD, TR SANDTRAP DRIVE, LOT #8 ON LEFT

SUBDIVISION BRITAIN HILLS BLOCK / SECTION LOT 8 LOT AREA 1 ACRE SITE CLASS PS DESIGN FLOW 360 L.T.A.R. 0.30 GPD/FT²

Septic Tank: 1000 Gallons; STB 1600 Date 11-26-01

Pump Tank: Gallons; PT Date

Pump Make: Model Serial No.

Nitrification Field: No Fields 1 Square Feet EQ. TO 1200 Linear Feet 200

No Lines FIVE Trench Width 24" Max Trench Bottom Depth 36"

☑ New System ☐ Repair System Type: I, II, III, IV, V, VI

System Description: 50% REDUCTION GRAVITY

Repair System Description: 50% REDUCTION GRAVITY

Maintenance Agreement Required: ☐ Yes ☑ No

☑ House/Mod. Home ☐ Mobile Home ☐ Business ☐ Other

No. Bedrooms 3 No. Bathrooms 2 No. Employees


Water Supply: ☐ Individual ☑ Public ☐ Community

Gravel Depth SAND 6" ☐ Slab ☑ Crawl Space ☐ Basement w/plumbing ☐ Basement wo/plumbing

Comments/Conditions: INSTALL 50% REDUCTION SYSTEM USING 45 PPBPS PANELS IN FIVE LINES

Comments/Conditions: SEPTIC TANK WITH MARKER INSTALLED USING "ZABEL" FILTER

INITIAL SITE SKETCH

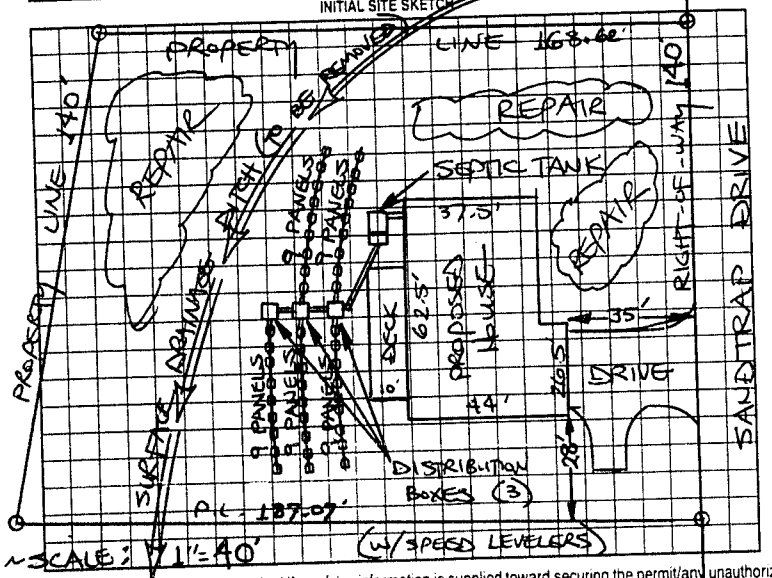

AS BUILT SKETCH

SYSTEM INSTALLED ACCORDING TO INITAL SITE SKETCH

Permit can be suspended or revoked if any false information is supplied toward securing the permit/any unauthorized changes are made to the site/any unauthorized changes are made in the installation of the system. Improvement Permit with plat valid without expiration. Improvement Permit with site plan valid for sixty months. Authorization to Construct is valid for a period equal to that of Improvement Permit – not to exceed sixty months.

Signed: [signature] date 12-17-01

Improvement Permit by: STEVE HEDRICK date 12-17-01

Authorization to Construct by: STEVE HEDRICK date 12-17-01

Installed by: JAKE MILLER

Operation Permit by: STEVE HEDRICK date 3-11-02

Existing System Inspection by: date

HEALTH DEPT. COPY WHITE OWNER COPY (FINAL) YELLOW OWNER COPY (INITIAL) PINK