IREDELL COUNTY HEALTH DEPARTMENT

STATESVILLE 704-878-5305 MOORESVILLE 704-664-5281

IMPROVEMENT PERMIT / AUTHORIZATION TO CONSTRUCT / OPERATION PERMIT / EXISTING SYSTEM INSPECTION

PERMIT# 8778 PIN# 4723378695 DATE Feb 21, 2000

OWNER OR CONTRACTOR LAFREDA PATTERSON PHONE: Business _____ Home 871-8903

ADDRESS 334 BREVARD APT F STATESVILLE

LOCATION HWY 70W @ AIRPORT LOT on RIGHT JUST PAST BRITTAIN HILL ENTRANCE

SUBDIVISION BRITTAIN HILLS BLOCK / SECTION _____ LOT 2 LOT AREA .62 SITE CLASS. PS DESIGN FLOW 360 L.T.A.R. .25

Septic Tank: 1000 Gallons; STB 160 Date 9-5-00
Pump Tank: _____ Gallons; PT _____ Date _____
Pump Make: _____ Model _____ Serial No. _____
Nitrification Field: No Fields 1 Square Feet 1440 Linear Feet 360
No Lines 5 Trench Width 36 Max Trench Bottom Depth 30" ~~ft~~

☑ New System ☐ Repair System Type: I ● II III IV V VI
System Description: GRAVITY 25% Reduction
Repair System Description: GRAVITY 50% Reduction
Maintenance Agreement Required: ☐ Yes ☒ No
Gravel Depth N/A ☐ Slab ☐ Crawl Space ☐ Basement w/plumbing ☐ Basement wo/plumbing

☒ House/Mod. Home No. Bedrooms 3
☐ Mobile Home No. Bathrooms 2
☐ Business No. Employees _____
☐ Other _____


Water Supply: ☐ Individual ☒ Public ☐ Community

Comments/Conditions: SUBSURFACE DRAINAGE DITCH BEGIN AT 42" DOWN
58 SHALLOW CHAMBERS OR 36 HS SECTIONS
MAY US DISTRIBUTION BOX & DROP BOXES
INSPECTION PORT AT END OF EACH LINE

Comments/Conditions: PROPERTY LINE TO DAYLIGHT
ZABEL (GRAY) FILTER INSTALLED, SEPTIC TANK WITH MARKER INSTALLED

1"=40ft SCALE

INITIAL SITE SKETCH

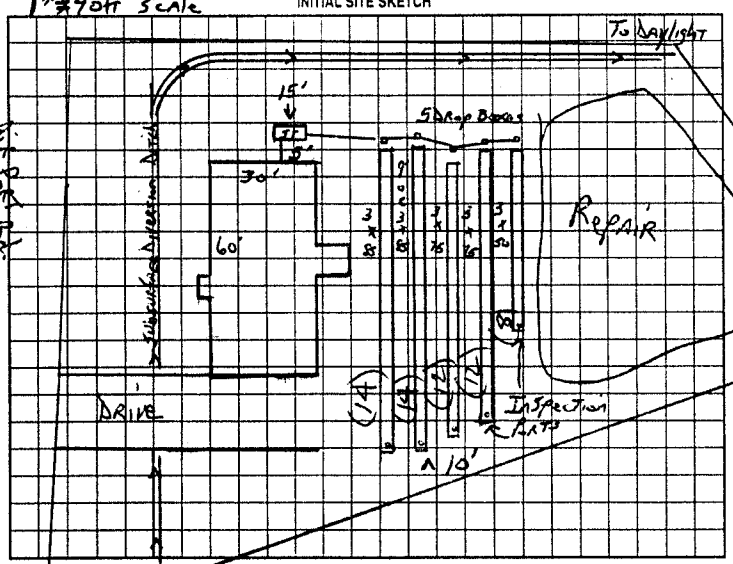

AS BUILT SKETCH

SYSTEM INSTALLED ACCORDING TO INITAL SITE SKETCH USING SIXTY (60) BIOAIRFILTER CHAMBERS AS SHOWN

Permit can be suspended or revoked if any false information is supplied toward securing the permit/any unauthorized changes are made to the site/any unauthorized changes are made in the installation of the system. Improvement Permit with plat valid without expiration. Improvement Permit with site plan valid for sixty months. Authorization to Construct is valid for a period equal to that of Improvement Permit – not to exceed sixty months.

Signed Lafreda A Patterson date 3/6/00 Installed by: DAVID UMBARGER

Improvement Permit by: J C Potts date Feb 21 2000 Operation Permit by: STEVE HEDRICK date 11-13-00

Authorization to Construct by: J C Potts date Feb 21, 2000 Existing System Inspection by: _____ date _____

HEALTH DEPT. COPY: WHITE OWNER COPY (FINAL): YELLOW OWNER COPY (INITIAL): PINK