47606

IREDELL COUNTY HEALTH DEPARTMENT

STATESVILLE 704-878-5305 MOORESVILLE 704-664-5281

IMPROVEMENT PERMIT / CERTIFICATE OF COMPLETION / OPERATION PERMIT / EXISTING SYSTEM INSPECTION

Watershed: ☐ Yes ☑ No

PROPERTY DESCRIPTION NO. 16479 DATE 11-15-93 TAX MAP NO. Pt. of. 6E-8-55

OWNER OR CONTRACTOR S. Jerome Bush PHONE: Business Home 872-0210

ADDRESS 315 Deaville Rd. Statesville, N.C. 28677

LOCATION I40W Tl Stamey Farm Rd T L Hwy 70 TR Airport Rd TR First entrance Parker Lake Loop, 4th house on L

SUBDIVISION NA BLOCK / SECTION LOT NA LOT AREA .65 acre SITE CLASS. P.S. DESIGN FLOW 360 L.T.A.R. .35 gpd/ft²

Septic Tank: 1000 Gallons: STB 825 Date 9-5-93

Pump Tank: — Gallons: PT — Date —

Pump Make: — Model — Serial No. —

Nitrification Field: No Fields 1 Square Feet 1035 Linear Feet 345'

No Lines 7 Trench Width 36" Max Trench Bottom Depth 32" Gravel Depth 12"

☑ New System ☐ Repair System Type: I, II, III, IV, V, VI

System Description: conventional, gravity

Repair System Description: Conventional, gravity if tank set in front yard

Maintenance Agreement Required: ☐ Yes ☑ No

☑ House/Mod. Home ☐ Mobile Home ☐ Business ☐ Other


No. Bedrooms 3 No. Bathrooms 2 No. Employees —

☐ Slab ☑ Crawl Space ☐ Basement w/plumbing ☐ Basement wo/plumbing

Water Supply: ☐ Individual ☐ Community ☑ Public


Comments: This permit voids permit issued 6-9-93. New permit issued due to improper location of house and trash pit dug. INSTALL SYSTEM SHALLOW (no deeper than 32" to trench bottom.) Keep lines on contour. Keep system 5' from foundation of home, 10' from all property lines, and 10' from water line. Keep system 15' from Fill Area. 100% Repair Area in front yards, conventional, gravity fed if plumbing changed and new tank set.

INITIAL SITE SKETCH

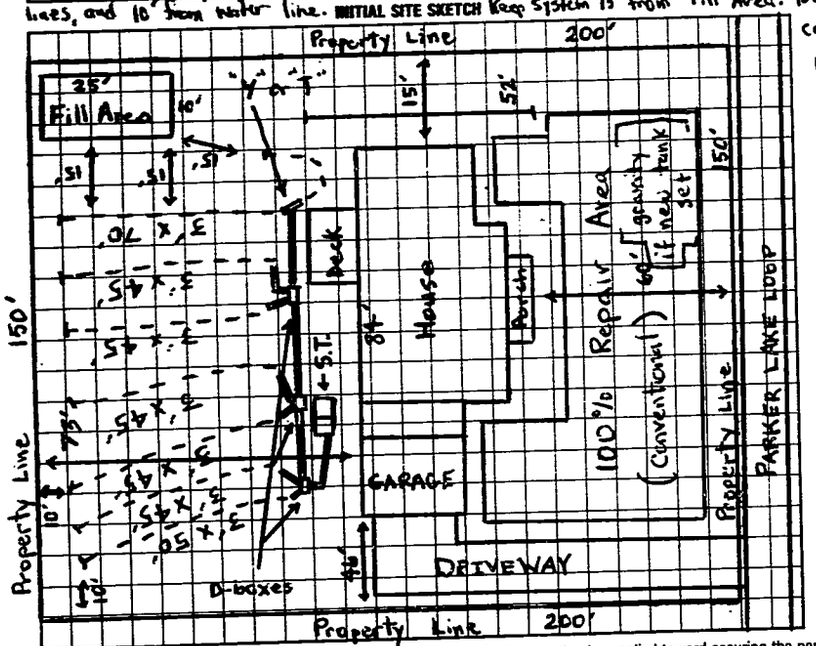

Comments: SYSTEM NOT INSTALLED THE WAY IT WAS PERMITTED. Start of trenches not installed 9'O.C. Area where lines were not 9'O.C. was not given credit for. Extra lines added to accomodate. 100% Repair Area in front of house, conventional, gravity if plumbing is changed and new tank set.

AS BUILT SKETCH

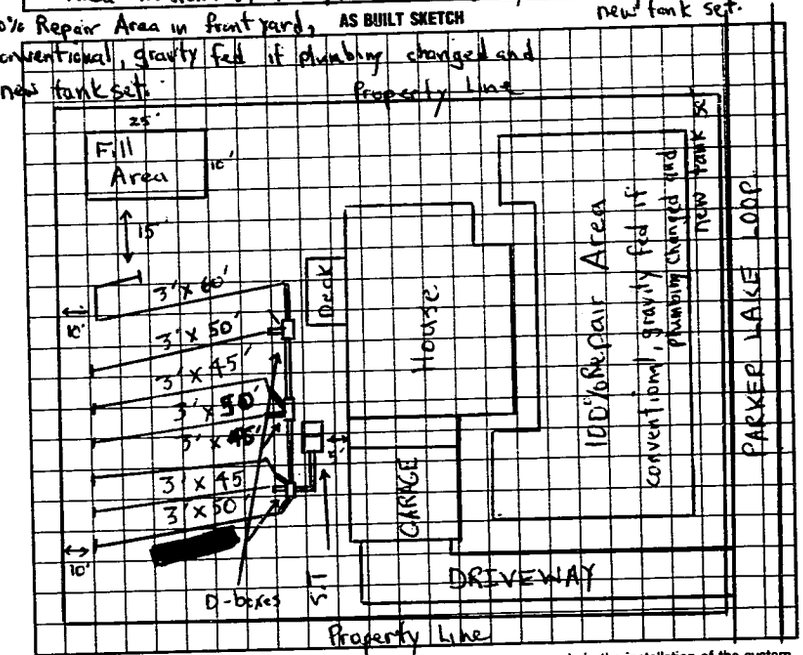

I understand that this permit can be suspended or revoked if any false information is supplied toward securing the permit/any unauthorized changes are made to the site/any unauthorized changes are made in the installation of the system. Improvement Permit is valid for 60 months from date of issuance.

Signed: S. Jerome Bush

Improvement Permit by: Michael J. Dennis date 11-15-93

Existing System Inspection by: date

Installed by: Rowan Septic Tank

Certificate of Completion by: Michael J. Dennis date 11-16-93

Operation Permit by: date

HEALTH DEPT. COPY: WHITE INSPECTION COPY (FINAL): GREEN OWNER COPY (FINAL): YELLOW INSPECTION COPY (INITIAL): PINK OWNER COPY (INITIAL): GOLD