Couldn't locate

IREDELL COUNTY HEALTH DEPARTMENT

STATESVILLE 704-878-5305 MOORESVILLE 704-664-5281 49472

IMPROVEMENT PERMIT / CERTIFICATE OF COMPLETION / OPERATION PERMIT / EXISTING SYSTEM INSPECTION

PROPERTY DESCRIPTION NO. 16998 DATE 9-21-93 TAX MAP NO. 6D-1-A-1

OWNER OR CONTRACTOR Debbie Davidson PHONE: Business Home 872-3162

ADDRESS Rt. 14 Box 176A Statesville, N.C. 28677

LOCATION I40W TL Stamey Farm Rd. TR Hwy 70 TR Airport Rd. Lot lot on R before golf course.

SUBDIVISION Brittain Hills S/D BLOCK / SECTION LOT 1 LOT AREA .583 acre SITE CLASS. P.S. L.T.A.R. .35 gpd/ft²

Water Supply: ☐ Individual ☐ Community ☑ Public county water

Septic Tank: 1000 Gallons; STB 1012 Date 9-12-93

Pump Tank: — Gallons; PT — Date —

Nitrification Field: No Fields 1 Square Feet 1035 Linear Feet 345'

☑ No Lines 6 Trench Width 36" Trench Depth 18"-36" Gravel Depth 12"

☑ New System ☐ Repair System Type: I (II) III IV V VI

System Description: Conventional, gravity

Repair System Description:

Maintenance Agreement Required: ☐ Yes ☑ No

☑ House/Mod. Home ☐ Mobile Home ☐ Business ☐ Other

No. Bedrooms 3 No. Bathrooms 2 No. Employees —

Garbage Disposal: ☐ Yes ☑ No

Auto. Dishwasher: ☑ Yes ☐ No


Auto. Washing Machine: ☑ Yes ☐ No

Other

☐ Slab ☑ Crawl Space ☐ Basement w/plumbing ☐ Basement wo/plumbing

Comments Keep Nitrification Lines on contour, keep system 5' from foundation of home, 10' from all property lines, and 10' min. from water line. 100% Repair Area below system, conventional, gravity fed.

INITIAL SITE SKETCH

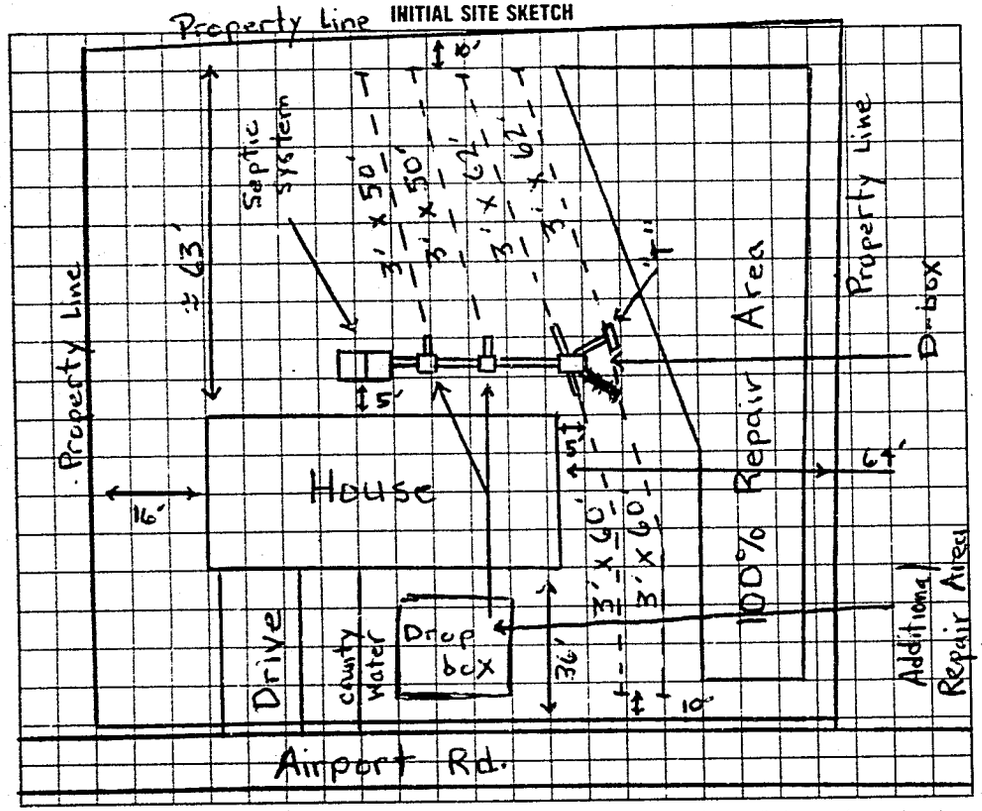

AS BUILT SKETCH

SAME AS INITIAL SKETCH

* Additional Repair Area in front yard (pump or re-route plumbing)

I understand that this permit can be suspended or revoked if any false information is supplied toward securing the permit/any unauthorized changes are made to the site/any unauthorized changes are made in the installation of the system. Improvement Permit is valid for 60 months from date of issuance.

Signed:

Improvement Permit by: Michael J. Dennis date 9-21-93

Existing System Inspection by: date

Installed by: JAMES HUDLER

Certificate of Completion by: Michael J. Dennis date 2-28-94

Operation Permit by: date

HEALTH DEPT. COPY WHITE INSPECTION COPY (FINAL) GREEN OWNER COPY (FINAL) YELLOW INSPECTION COPY (INITIAL) PINK OWNER COPY (INITIAL) GOLD