IREDELL COUNTY HEALTH DEPARTMENT

STATESVILLE 704-878-5305 MOORESVILLE 704-664-5281

IMPROVEMENT PERMIT / CERTIFICATE OF COMPLETION / OPERATION PERMIT / EXISTING SYSTEM INSPECTION

PROPERTY DESCRIPTION NO. 25620 DATE 12-13-96 TAX MAP NO. 65-B-3 (PART) Watershed: ☐ Yes ☑ No

OWNER OR CONTRACTOR REBECCA KISAR // DIANE BEAVER PHONE: Business 872-5884 Home 872-5497

ADDRESS

LOCATION US 70 W, TL AIRPORT ROAD, TL ANGSDALE RD, LOT # 11 ON RIGHT

SUBDIVISION REDMONDS BLOCK / SECTION LOT 11 LOT AREA LIMITED SITE CLASS P3 DESIGN FLOW 360 GPD T.A.R. EXISTING

Septic Tank: 1000 Gallons; STB Date

Pump Tank: Gallons; PT Date

Pump Make: Model Serial No.

Nitrification Field: No Fields 1 Square Feet 720 Linear Feet 240

No Lines THREE Trench Width Max Trench Bottom Depth Gravel Depth

☐ New System ☐ Repair System Type: ☐ I ☐ II ☐ III ☐ IV ☐ V ☐ VI

System Description: CONV. GRAVITY

Repair System Description:

Maintenance Agreement Required: ☐ Yes ☑ No

☐ Slab ☑ Crawl Space ☐ Basement w/plumbing ☐ Basement wo/plumbing

☐ House/Mod. Home No. Bedrooms 3

☑ Mobile Home No. Bathrooms 2

☐ Business No. Employees

☐ Other


Water Supply: ☐ Individual ☐ Community ☑ Public

Comments:

Comments: ① SYSTEM IS UNDERSIZED ACCORDING TO TODAY'S STANDARDS & INSTALLED EXTREMELY DEEP ② SYSTEM APPEARS TO HAVE BEEN SATURATED & MAY BE CLOSE TO FAILURE —

INITIAL SITE SKETCH

AS BUILT SKETCH

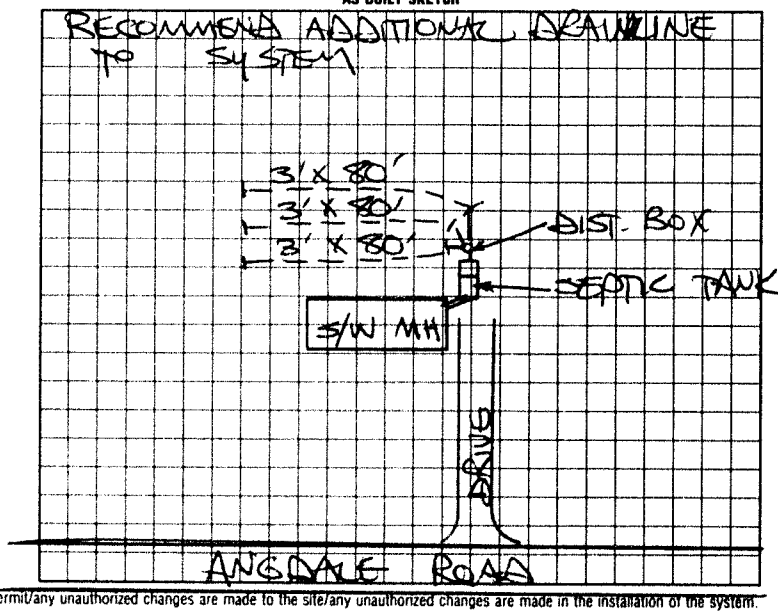

I understand that this permit can be suspended or revoked if any false information is supplied toward securing the permit/any unauthorized changes are made to the site/any unauthorized changes are made in the installation of the system. Improvement Permit is valid for 60 months from date of issuance

Signed:

Improvement Permit by: date

Existing System Inspection by: STEVE HENDRICK date 12-13-96

Installed by

Certificate of Completion by date

Operation Permit by date

HEALTH DEPT. COPY: WHITE INSPECTION COPY (FINAL) GREEN OWNER COPY (FINAL) YELLOW INSPECTION COPY (INITIAL) PINK OWNER COPY (INITIAL) GOLD