IREDELL COUNTY HEALTH DEPARTMENT

STATESVILLE 704-878-5305 (C1) MOORESVILLE 704-664-5281

IMPROVEMENT PERMIT / AUTHORIZATION TO CONSTRUCT / OPERATION PERMIT / EXISTING SYSTEM INSPECTION

(1)

PERMIT# 1166663 PIN# 4723-49-4330 DATE 11-7-03

OWNER OR CONTRACTOR WILLIAM C. REDMOND PHONE: Business Home 704-878-2506

ADDRESS 174 ANGDALE LANE, STATESVILLE, NC 28677

LOCATION US 70 WEST, TL AIRPORT ROAD, TL ANGDALE LANE, MOBILE HOME SITE AT END

SUBDIVISION BLOCK / SECTION LOT LOT AREA 4.84 ACRES SITE CLASS. PS DESIGN FLOW 240 L.T.A.R. 0.30 GPD/FT²

Septic Tank: 1000 Gallons; STB 794 Date 9-11-01

Pump Tank: Gallons; PT Date

Pump Make: Model Serial No.

Nitrification Field: No Fields 1 Square Feet 810 Linear Feet 270

No Lines THREE Trench Width 36" Max Trench Bottom Depth 36" Gravel Depth 12"

☑ New System ☐ Repair System Type: I, II, III, IV, V, VI

System Description: CONVENTIONAL, GRAVITY

Repair System Description: CONVENTIONAL, GRAVITY

Maintenance Agreement Required: ☐ Yes ☑ No

☐ House/Mod. Home ☑ Mobile Home ☐ Business ☐ Other

No. Bedrooms 2 No. Bathrooms 2 No. Employees


☐ Slab ☑ Crawl Space ☐ Basement w/plumbing ☐ Basement wo/plumbing

Water Supply: ☑ Individual ☐ Public ☐ Community

Comments:/Conditions: (2) KEEP SYSTEM MINIMUM 100 FEET FROM WELL (2) INSTALL LINES ON CONTOUR AS FLAGGED.

Comments:/Conditions: SEPTIC TANK WITH MARKER INSTALLED USING "BABEL" FILTER

INITIAL SITE SKETCH

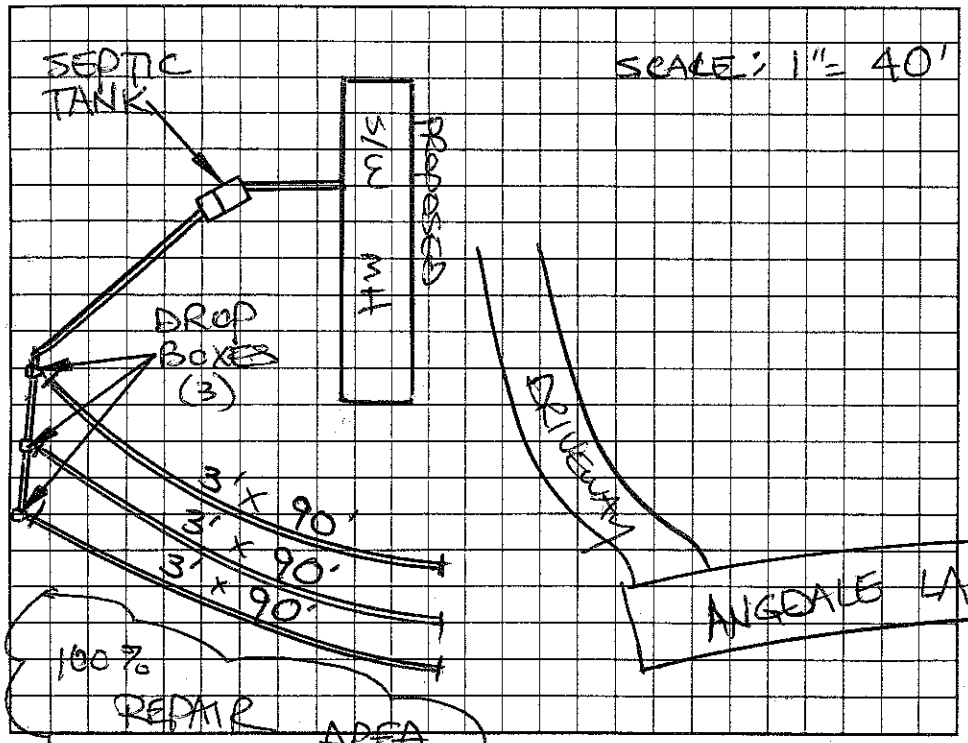

AS BUILT SKETCH

SYSTEM INSTALLED ACCORDING TO INITIAL SITE SKETCH

Permit can be suspended or revoked if any false information is supplied toward securing the permit/any unauthorized changes are made to the site/any unauthorized changes are made in the installation of the system. Improvement Permit with plat valid without expiration. Improvement Permit with site plan valid for sixty months. Authorization to Construct is valid for a period equal to that of Improvement Permit -- not to exceed sixty months.

Signed: x William C Redmond date 11/07/03

Improvement Permit by: STEVE HEDRICK date 11-7-03

Authorization to Construct by: STEVE HEDRICK date 11-7-03

Installed by: KENNY MADISON

Operation Permit by: STEVE HEDRICK date 11-10-03

Existing System Inspection by: date

HEALTH DEPT. COPY: WHITE OWNER COPY (FINAL): YELLOW OWNER COPY (INITIAL): PINK