IREDELL COUNTY HEALTH DEPARTMENT

STATESVILLE 704-878-5305 MOORESVILLE 704-664-5281

IMPROVEMENT PERMIT / CERTIFICATE OF COMPLETION / OPERATION PERMIT / EXISTING SYSTEM INSPECTION

PROPERTY DESCRIPTION NO. 20283 DATE 2-13-97 TAX MAP NO. 6D-A-4 Watershed: ☐ Yes ☒ No

OWNER OR CONTRACTOR ~~Darin St~~ Lakewood Golf Club PHONE: Business 8736441 Home

ADDRESS Buffalo Shoals Rd TR Airport Rd Rest Stop on Rt side By holes 17

LOCATION Airport Rd Statesville NC 28677

SUBDIVISION BLOCK / SECTION LOT LOT AREA 115 Ac. SITE CLASS. P/S DESIGN FLOW 135 L.T.A.R. 0.3

Septic Tank: 1000 Gallons; STB 794 Date 11-4-96

Pump Tank: Gallons; PT Date

Pump Make: Model Serial No.

Nitrification Field: No Fields 1 Square Feet 450 Linear Feet 150

No Lines 2 Trench Width 36in Max Trench Bottom Depth 24in Gravel Depth —

☒ New System ☐ Repair System Type: I, II, (III) IV, V, VI

System Description: Grant Chamber

Repair System Description: Pump/Gravity Operation/ chambers

Maintenance Agreement Required: ☐ Yes ☒ No

☐ Slab ☐ Crawl Space ☐ Basement w/plumbing ☐ Basement wo/plumbing

☐ House/Mod. Home No. Bedrooms

☐ Mobile Home No. Bathrooms

☐ Business No. Employees


☒ Other Rest stop

Water Supply:
☐ Individual
☐ Community
☐ Public


Comments: Keep lines on contour 9ft on center
Keep upper line close to Tree line

Comments:

INITIAL SITE SKETCH

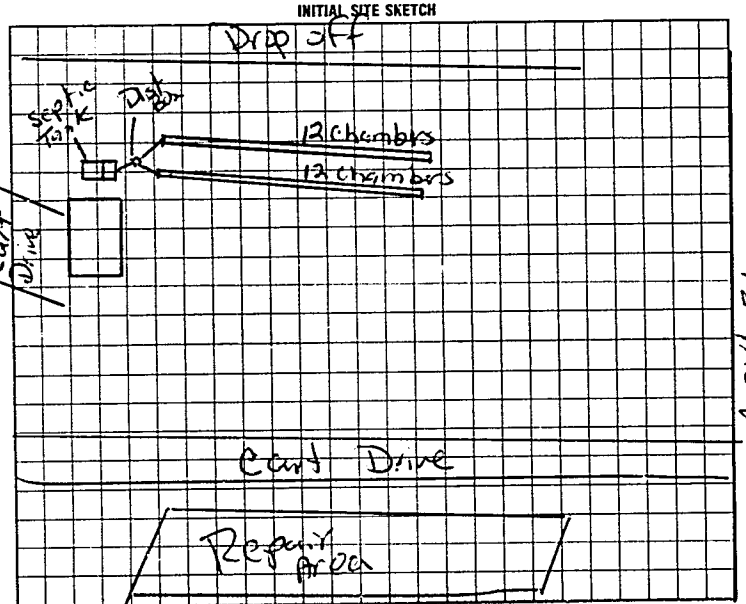

AS BUILT SKETCH

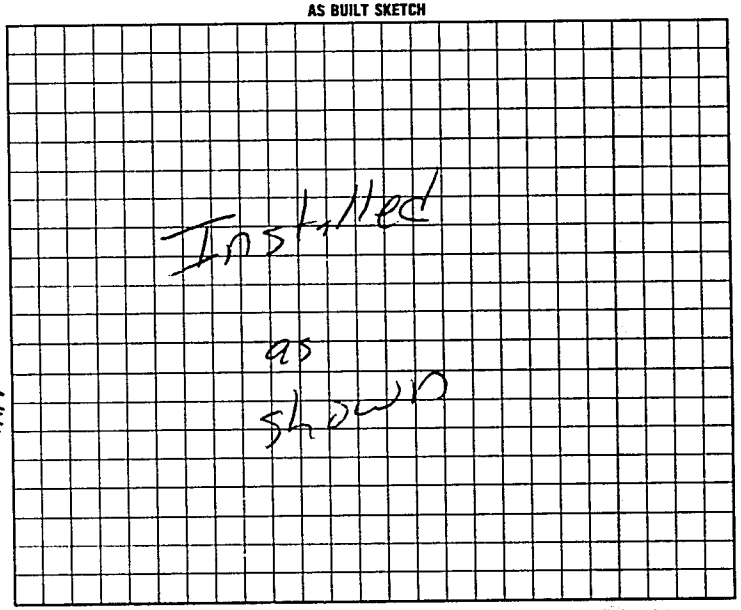

I understand that this permit can be suspended or revoked if any false information is supplied toward securing the permit/any unauthorized changes are made to the site/any unauthorized changes are made in the installation of the system. Improvement Permit is valid for 60 months from date of issuance. Authorization to construct expires 5 yrs from issue date

Signed:

Improvement Permit by: Mark Cox RS date 2-13-97

Existing System Inspection by: Mark Cox RS date 2-13-97

Installed by: James Huddlex

Certificate of Completion by: date

Operation Permit by: Mark Cox RS date 2-26-97

HEALTH DEPT. COPY WHITE INSPECTION COPY (FINAL) GREEN OWNER COPY (FINAL) YELLOW INSPECTION COPY (INITIAL) PINK OWNER COPY (INITIAL): GOLD