IREDELL COUNTY HEALTH DEPARTMENT

STATESVILLE 704-878-5305 MOORESVILLE 704-664-5281

IMPROVEMENT PERMIT / CERTIFICATE OF COMPLETION / OPERATION PERMIT / EXISTING SYSTEM INSPECTION

PROPERTY DESCRIPTION NO. 20282 DATE 2-13-97 TAX MAP NO. 6D-A-4 Watershed: ☐ Yes ☐ No

OWNER OR CONTRACTOR Lakewood Gulf Club PHONE: Business 873-6441 Home

ADDRESS 390 Airport Rd Statesville NC

LOCATION Buffalo Shoals Rd TR Airport Rest stop on left hand side hole # 4

SUBDIVISION BLOCK / SECTION LOT LOT AREA 1.15 Ac. SITE CLASS. P/S DESIGN FLOW 135 L.T.A.R. 0.3

Septic Tank: 1000 Gallons; STB 794 Date 12-4-96

Pump Tank: Gallons; PT Date

Pump Make: Model Serial No.

Nitrification Field: No Fields 1 Square Feet 450 Linear Feet 150

No Lines 2 Trench Width 36in Max Trench Bottom Depth 36in Gravel Depth —

☒ New System ☐ Repair System Type: I, II, III, IV, V, VI

System Description: Quick Chamber

Repair System Description: Quick / Pump Chamber

Maintenance Agreement Required: ☐ Yes ☒ No

☐ Slab ☐ Crawl Space ☐ Basement w/plumbing ☐ Basement wo/plumbing

☐ House/Mod. Home No. Bedrooms

☐ Mobile Home No. Bathrooms

☐ Business No. Employees


☒ Other Rest Stop

Water Supply: ☐ Individual ☐ Community ☒ Public


Comments: keep lines on contour 9ft on center.

Comments:

INITIAL SITE SKETCH

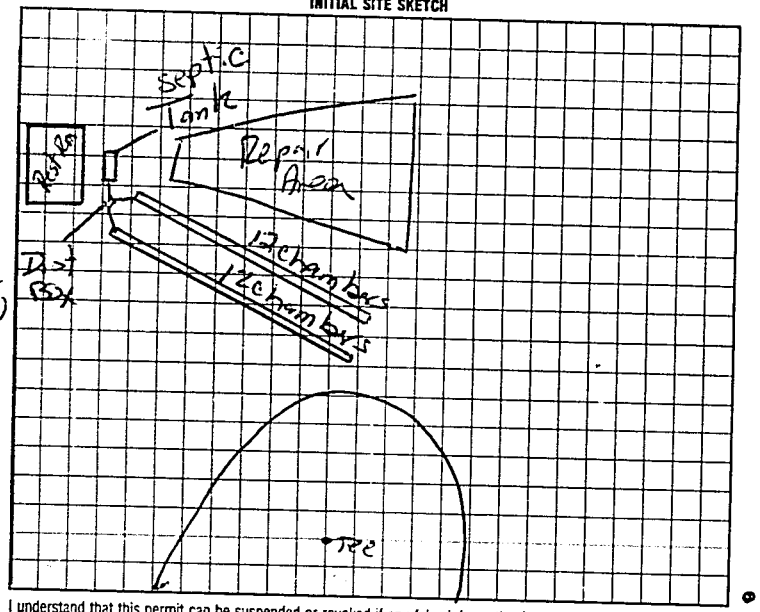

AS BUILT SKETCH

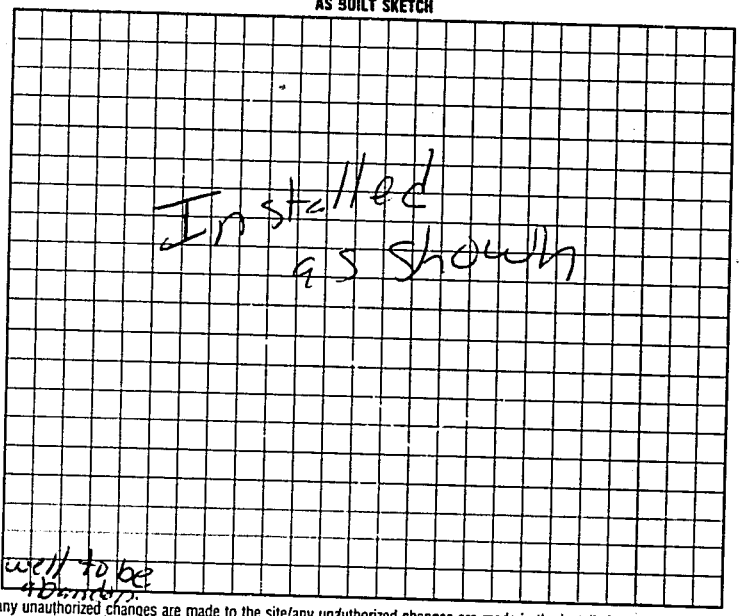

I understand that this permit can be suspended or revoked if any false information is supplied toward securing the permit/any unauthorized changes are made to the site/any unauthorized changes are made in the installation of the system. Improvement Permit is valid for 60 months from date of issuance. Authorization to construct expires 5yrs from issue date

Signed:

Improvement Permit by: Mark C Ott date 2-13-97

Existing System Inspection by: Mark C Ott date 2-13-97

Installed by: Jones Huddlor

Certificate of Completion by: date

Operation Permit by Mark C Ott RS date 2-26-97

HEALTH DEPT COPY WHITE INSPECTION COPY (FINAL) GREEN OWNER COPY (FINAL) YELLOW INSPECTION COPY (INITIAL) PINK OWNER COPY (INITIAL) GOLD