89351

IREDELL COUNTY HEALTH DEPARTMENT

STATESVILLE 704-878-5305 MOORESVILLE 704-664-5281

IMPROVEMENT PERMIT / CERTIFICATE OF COMPLETION / OPERATION PERMIT / EXISTING SYSTEM INSPECTION

PROPERTY DESCRIPTION NO. 21214 DATE 4-14-97 TAX MAP NO. 6C-N-A-44,45,46 Watershed: ☐ Yes ☑ No

OWNER OR CONTRACTOR Scott H. Johnson PHONE: Business _____ Home 878-2282

ADDRESS 411 Brookdale Dr.

LOCATION Buffalo Shoals Turn sta, Grantview TL Galax TL Crickett at end

SUBDIVISION Glenn Ridge BLOCK / SECTION _____ LOT 44,45,46 LOT AREA 3.5 acres SITE CLASS PS DESIGN FLOW 360 L.T.A.R. .3

Septic Tank: 1000 Gallons; STB 794 Date 9-11-00

Pump Tank: _____ Gallons; PT _____ Date _____

Pump Make: _____ Model _____ Serial No. _____

Nitrification Field: No Fields 1 Square Feet 1200 Linear Feet 400

No Lines 4 Trench Width 36" Max Trench Bottom Depth 36" Gravel Depth 12"

☑ New System ☐ Repair System Type: I, II, III, IV, V, VI

System Description: conv. Gravity

Repair System Description: Pump To Conv. lines

Maintenance Agreement Required: ☐ Yes ☑ No

☑ House/Mod. Home No. Bedrooms 3

☐ Mobile Home No. Bathrooms 2

☐ Business No. Employees _____

☐ Other _____


☐ Slab ☐ Crawl Space ☐ Basement w/plumbing ☑ Basement wo/plumbing

Water Supply: ☑ Individual ☐ Community ☐ Public


Comments: Buffalo Shoals

Comments: ① INSTALLED AS SHOWN with MARICOR + with sanitary tee.

INITIAL SITE SKETCH

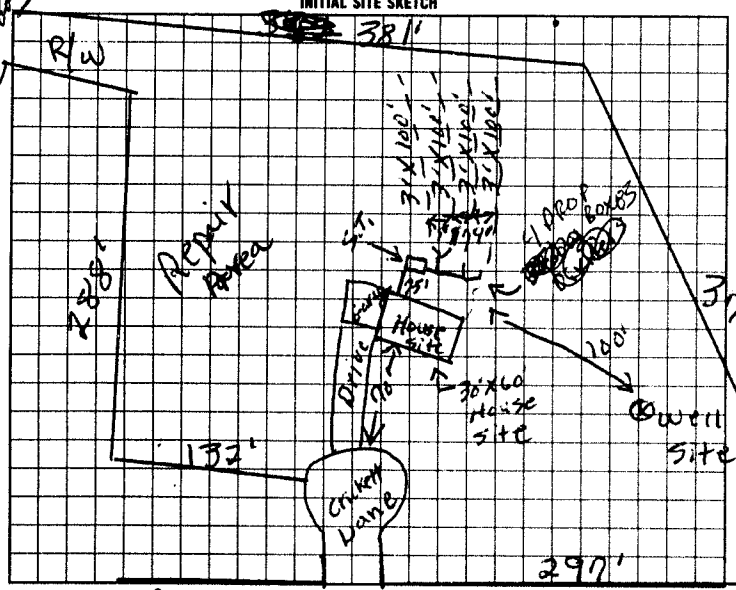

AS BUILT SKETCH

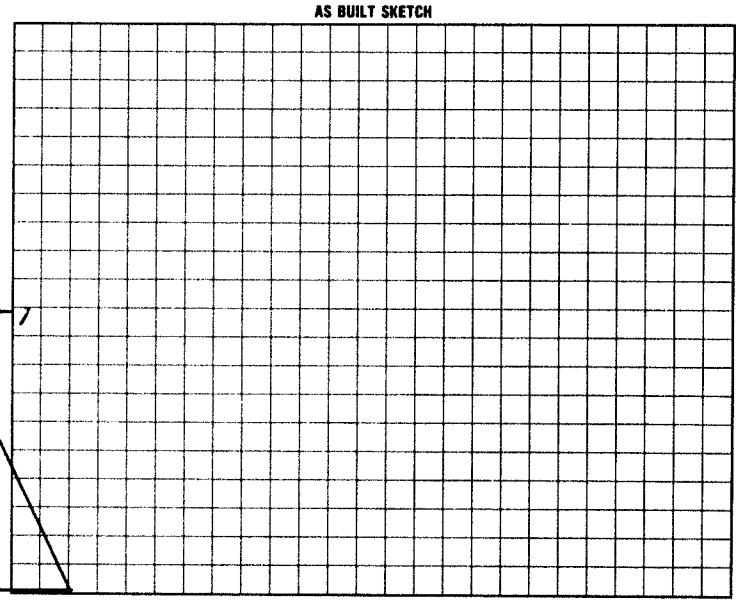

I understand that this permit can be suspended or revoked if any false information is supplied toward securing the permit/any unauthorized changes are made to the site/any unauthorized changes are made in the installation of the system. Improvement Permit is valid for 60 months from date of issuance.

Signed: Scott H. Johnson

Improvement Permit by: P.C. moore date 4-14-97

~~Existing System Inspection by:~~ Authorization to cover P.C. moore date 4-14-97

Installed by: WES LITTON

Certificate of Completion by: _____ date 03-08-01

Operation Permit by: _____ date _____

HEALTH DEPT. COPY: WHITE INSPECTION COPY (FINAL): GREEN OWNER COPY (FINAL): YELLOW INSPECTION COPY (INITIAL): PINK OWNER COPY (INITIAL): GOLD

Authorization to cover. Expires 60 mos from issue