IREDELL COUNTY HEALTH DEPARTMENT

STATESVILLE 704-878-5305 MOORESVILLE 704-664-5281

IMPROVEMENT PERMIT / CERTIFICATE OF COMPLETION / OPERATION PERMIT / EXISTING SYSTEM INSPECTION

PROPERTY DESCRIPTION NO. 26154-77549 DATE 3-14-97 TAX MAP NO. 11723507951 Watershed: ☐ Yes ☒ No

OWNER OR CONTRACTOR David Meehan PHONE: Business _____ Home 546-2254

ADDRESS PO Box 1616 Davidson NC 28036

LOCATION Buffalo Shoals TR Glen Ridge TL Galax Dr 1st lot on left

SUBDIVISION Glen Ridge BLOCK / SECTION _____ LOT 49 LOT AREA _____ SITE CLASS P/S DESIGN FLOW 360 L.T.A.R. 0.3

Septic Tank: 1000 Gallons; STB 1012 Date 1-22-99
Pump Tank: _____ Gallons; PT _____ Date _____
Pump Make: _____ Model _____ Serial No. _____
Nitrification Field: No Fields 1 Square Feet 900 Linear Feet 300
No Lines 4 Trench Width 36in Max Trench Bottom Depth 36in ~~Gravel~~ Depth Sand

☒ New System ☐ Repair System Type: I, II, IIIb, IV, V, VI
System Description: Gravity Chambers
Repair System Description: Gravity Panels
Maintenance Agreement Required: ☐ Yes ☒ No


☒ House/Mod. Home ☐ Mobile Home ☐ Business ☐ Other
No. Bedrooms 3 No. Bathrooms 3½ No. Employees _____
☐ Slab ☒ Crawl Space ☐ Basement w/plumbing ☐ Basement wo/plumbing

Water Supply: ☒ Individual ☐ Community ☐ Public


Comments: Keep lines on contour 9ft on center Use Earth Dams Keep well Max distance

Comments:

INITIAL SITE SKETCH

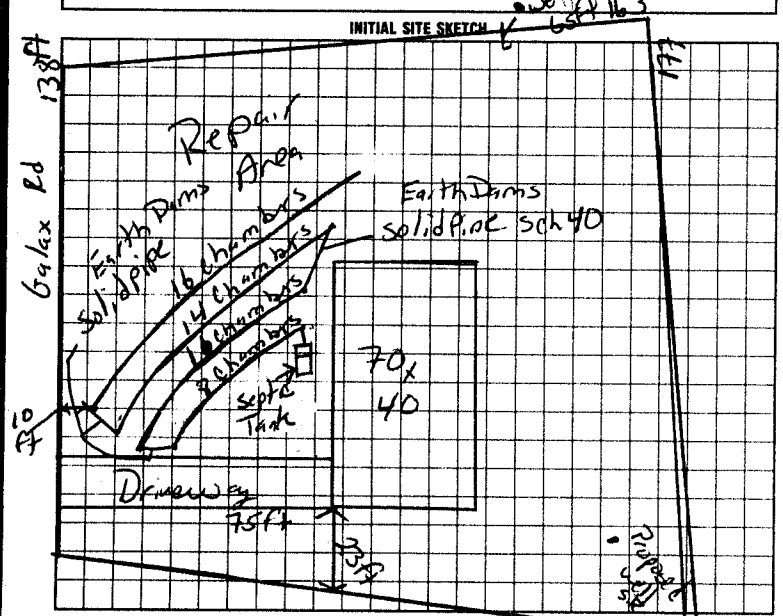

AS BUILT SKETCH

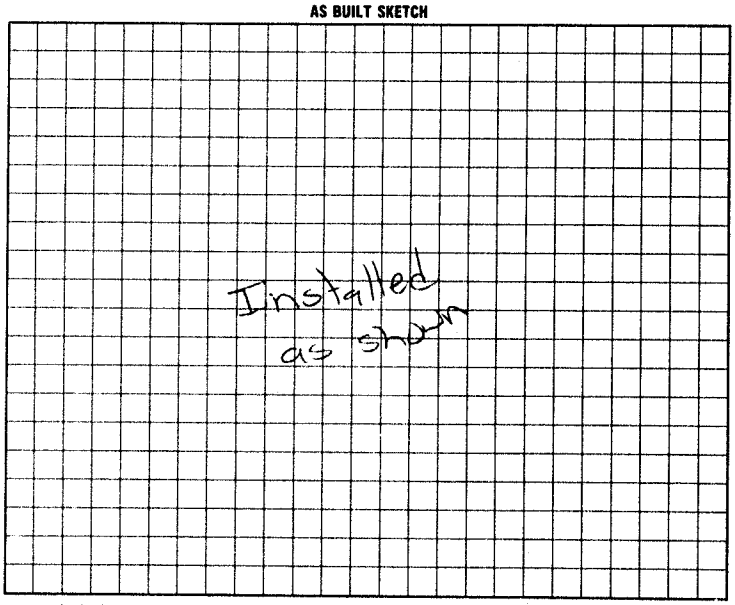

I understand that this permit can be suspended or revoked if any false information is supplied toward securing the permit/any unauthorized changes are made to the site/any unauthorized changes are made in the installation of the system. Improvement Permit is valid for 60 months from date of issuance. Authorization to construct expires 5yrs from issue date

Signed: X David Meehan

Improvement Permit by: Mary C Ott RS date 3-14-97

Existing System Inspection by: Authorization to const. Mary C Ott RS date 3-14-97

Installed by: Tommy Frye

Certificate of Completion by: _____ date _____

Operation Permit by: Mary C Ott RS date 3-30-99

HEALTH DEPT. COPY: WHITE INSPECTION COPY (FINAL): GREEN OWNER COPY (FINAL): YELLOW INSPECTION COPY (INITIAL): PINK OWNER COPY (INITIAL): GOLD