IREDELL COUNTY HEALTH DEPARTMENT

STATESVILLE 704-878-5305 MOORESVILLE 704-664-5281

IMPROVEMENT PERMIT / AUTHORIZATION TO CONSTRUCT / OPERATION PERMIT / EXISTING SYSTEM INSPECTION

PERMIT# 072879 PIN# 4723 51 4119 DATE 4-6-98

OWNER OR CONTRACTOR ANGELA & JAMES TRENT PHONE: Business B. ELLENBURG 528-6251 Home 528-6251

ADDRESS 121 S. ELM ST. STATESVILLE, NC 28677

LOCATION BUFFALO SHOALS ROAD, TR GRANDVIEW, TL GALAX, 4TH LOT ON RIGHT

SUBDIVISION GLEN RIDGE BLOCK / SECTION ____ LOT 40 LOT AREA 0.872 ACRE SITE CLASS. PS DESIGN FLOW 360 L.T.A.R. 0.30 GPD/FT²

Septic Tank: 1000 Gallons; STB 794 Date 1-21-98
Pump Tank: ____ Gallons; PT ____ Date ____
Pump Make: ____ Model ____ Serial No. ____
Nitrification Field: No Fields 1 Square Feet 1200 Linear Feet 400
No Lines FOUR Trench Width 36" Max Trench Bottom Depth 24"

☑ New System ☐ Repair System Type: I, II, III, IV, V, VI
System Description: CONVENTIONAL GRAVITY
Repair System Description: CONV. GRAVITY
Maintenance Agreement Required: ☐ Yes ☑ No
Gravel Depth 12"

☑ House/Mod. Home No. Bedrooms 3
☐ Mobile Home No. Bathrooms 2
☐ Business No. Employees ____
☐ Other ____


☐ Slab ☑ Crawl Space ☐ Basement w/plumbing ☐ Basement wo/plumbing

Water Supply: ☑ Individual ☐ ~~Public~~ ☐ Community


Comments:/Conditions: ① KEEP SYSTEM MINIMUM 100' FROM WELL ② USE DROP BOXES FOR SERIAL DISTRIBUTION.

Comments:/Conditions:

INITIAL SITE SKETCH SCALE: 1" = 50'

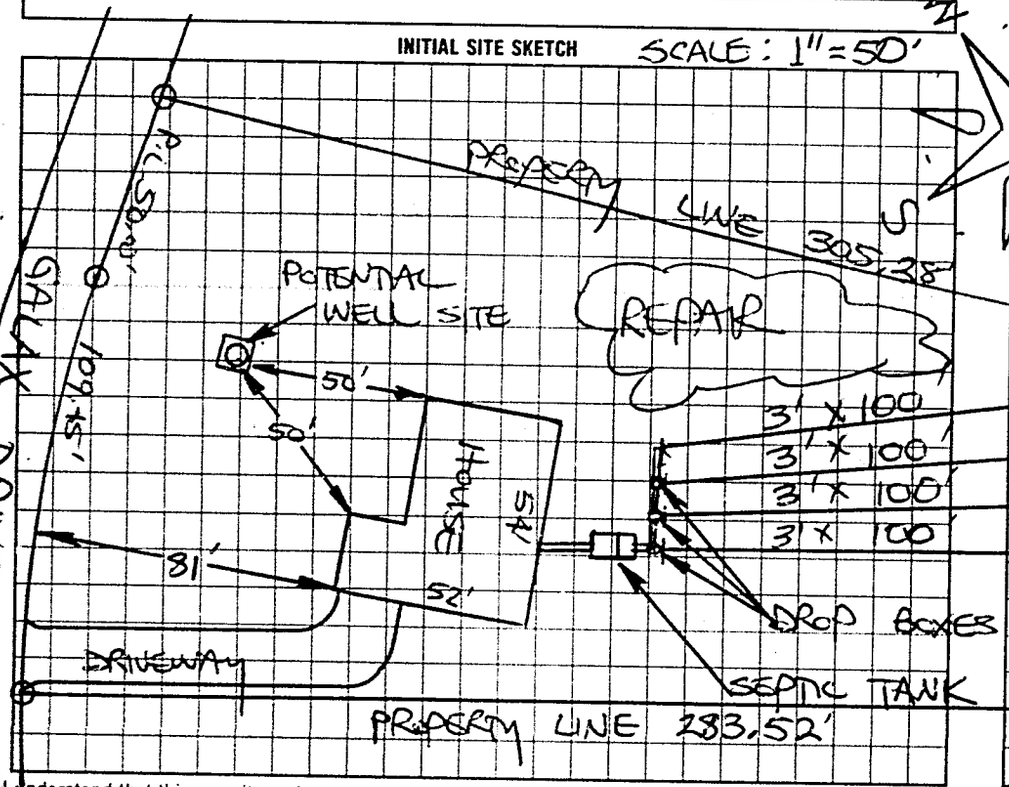

AS BUILT SKETCH

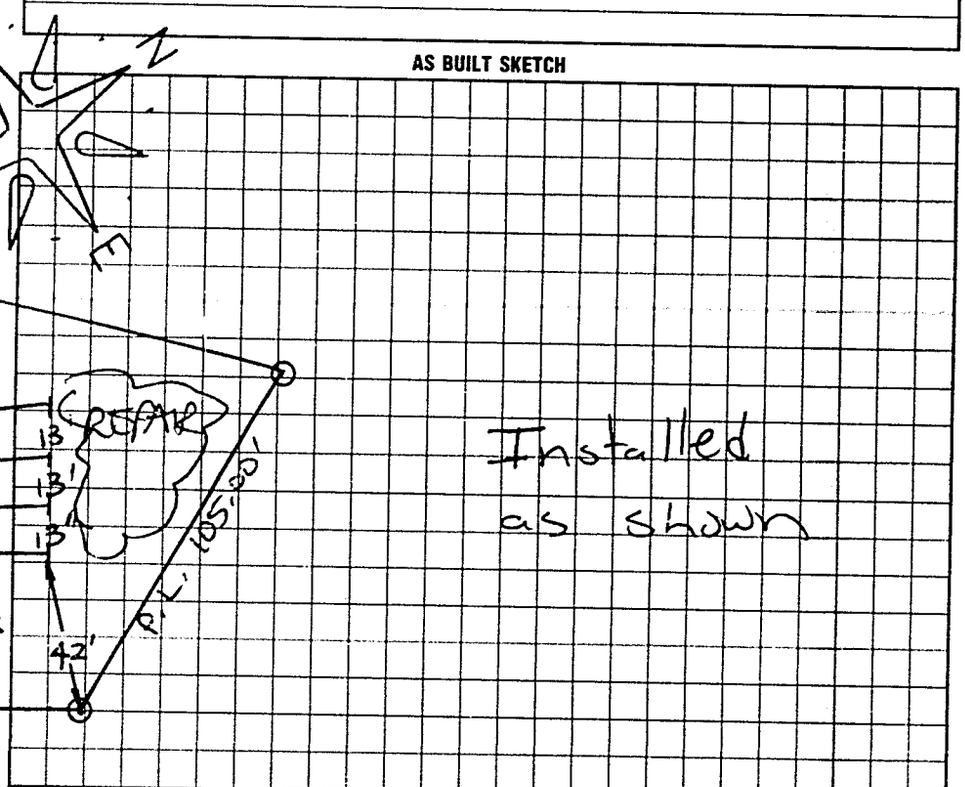

I understand that this permit can be suspended or revoked if any false information is supplied toward securing the permit/any unauthorized changes are made to the site/any unauthorized changes are made in the installation of the system. Improvement Permit with plat valid without expiration. Improvement Permit with site plan valid for sixty months. Authorization to Construct is valid for a period equal to that of Improvement Permit – not to exceed sixty months.

Signed: [signature] date 4-6-98

Improvement Permit by: STEVE HEDRICK date 4-6-98

Authorization to Construct by: STEVE HEDRICK date 4-6-98

Installed by: James Hudlow

Operation Permit by: M+C Outfits date 7-1-98

Existing System Inspection by ____ date ____

HEALTH DEPT. COPY WHITE INSPECTION COPY (FINAL) GREEN OWNER COPY (FINAL) YELLOW INSPECTION COPY (INITIAL) PINK OWNER COPY (INITIAL) GOLD

265000