IREDELL COUNTY HEALTH DEPARTMENT

Authorization to const.

STATESVILLE 704-878-5305 MOORESVILLE 704-664-5281

IMPROVEMENT PERMIT / ~~CERTIFICATE OF COMPLETION~~ / OPERATION PERMIT / EXISTING SYSTEM INSPECTION

PROPERTY DESCRIPTION NO. 2533 2012852 DATE 10-23-96 TAX MAP NO. 6C 7A 39

OWNER OR CONTRACTOR Harry Hope PHONE: Business 871-6792 Home 241-2131

ADDRESS 7870 Long Island Rd Catawba NC Watershed: ☐ Yes ☒ No

LOCATION I-40 TL old Mtn TR Buffalo Shoals TL Greenview TL Galax 3lot on Right

SUBDIVISION Glen Ridge BLOCK / SECTION LOT 39 LOT AREA SITE CLASS. P/S DESIGN FLOW 360 L.T.A.R. 0.30

Septic Tank: 1000 Gallons; STB 794 Date 4-29-98

Pump Tank: Gallons; PT Date

Pump Make: Model Serial No.

Nitrification Field: No Fields 1 Square Feet 1200 Linear Feet 400

No Lines 5 Trench Width 36" Max Trench Bottom Depth 30in Gravel Depth 12 in

☒ New System ☐ Repair System Type: I, ☒ III, IV, V, VI

System Description: Gravity Conventional

Repair System Description: Gr. ~~Conv.~~ Shallow

Maintenance Agreement Required: ☐ Yes ☐ No Chamber Rock

☒ House/Mod. Home ☐ Mobile Home ☐ Business ☐ Other

No. Bedrooms 3 No. Bathrooms 2 No. Employees


Water Supply: ☒ Individual ☐ Community ☐ Public

☐ Slab ☒ Crawl Space ☐ Basement w/plumbing ☐ Basement wo/plumbing


Comments: keep lines on Contour 9ft on center
Smooth out Terraces, use 4 Drop Boxes
keep Trench 30in Deep max.

Comments:

INITIAL SITE SKETCH

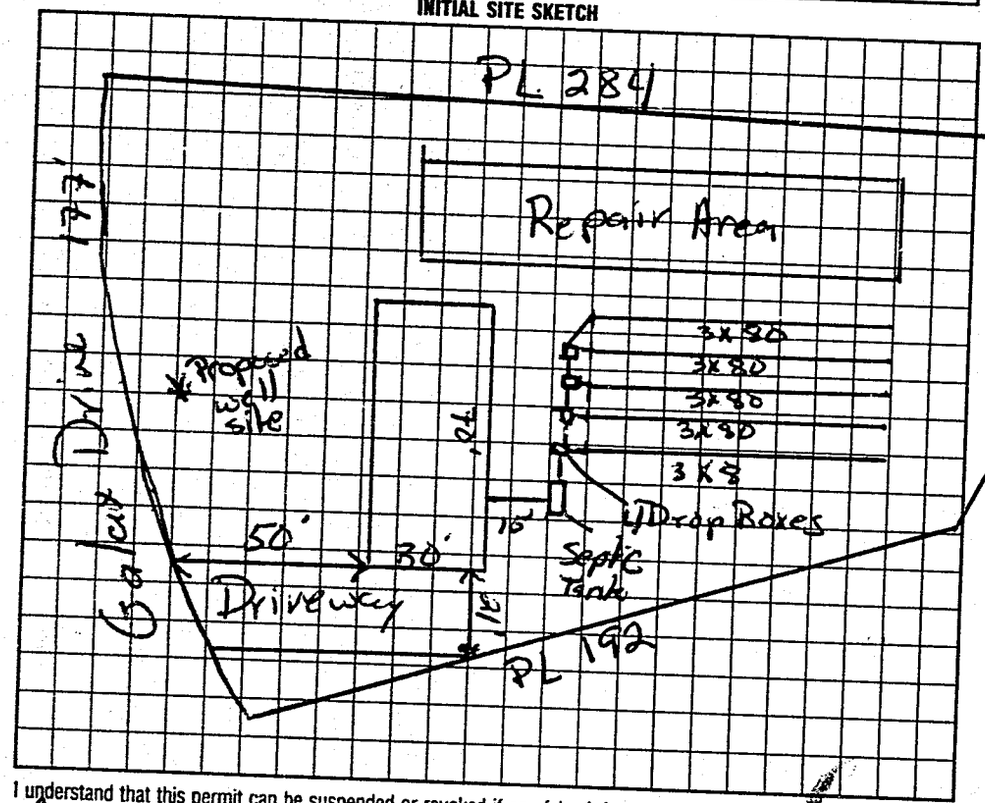

AS BUILT SKETCH

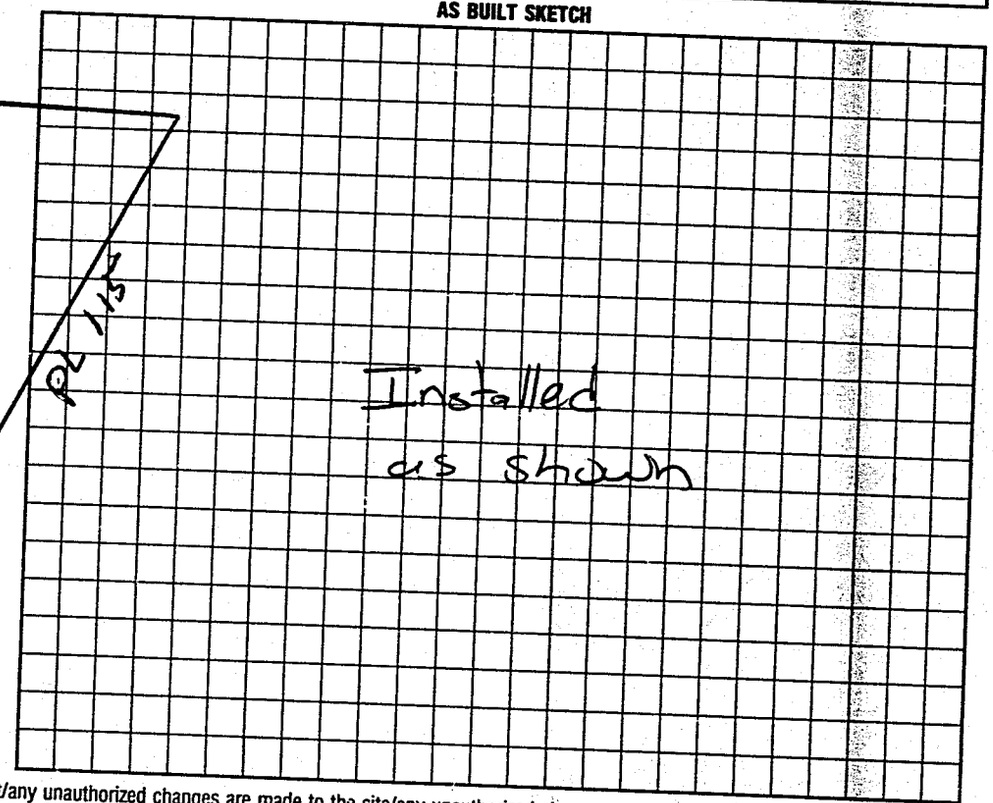

I understand that this permit can be suspended or revoked if any false information is supplied toward securing the permit/any unauthorized changes are made to the site/any unauthorized changes are made in the installation of the system.

Authorization to const expires 5yrs after date of issue

Signed: X Harry Hope

Improvement Permit by: Mark C. Oates RS date 10-24-96 Installed by: James Hudler

Existing System Inspection by: Authorization to const Mark C. Oates RS date 10-24-96 Certificate of Completion by: date

Operation Permit by: Mark C. Oates RS date 7-1-98

HEALTH DEPT. COPY: WHITE INSPECTION COPY (FINAL): GREEN OWNER COPY (FINAL): YELLOW INSPECTION COPY (INITIAL): PINK OWNER COPY (INITIAL): GOLD