* THIS PERMIT REPLACES EXPIRED PERMIT ISSUED ON 07/24/95

IREDELL COUNTY HEALTH DEPARTMENT

STATESVILLE 704-878-5305 CI MOORESVILLE 704-664-5281

IMPROVEMENT PERMIT / AUTHORIZATION TO CONSTRUCT / OPERATION PERMIT / EXISTING SYSTEM INSPECTION

PERMIT# 107533 PIN# 4723-51-7695 DATE 01/15/03

OWNER OR CONTRACTOR JAMES AHNER PHONE: Business 908-507-5555 Home 732-752-8468

ADDRESS 334 WILLIAM ST. PISCATWAY, N.J. 08854 RICK WILSON 704-902-2343

LOCATION OLD MTN. RD, (L) BUFFALO SHOALS RD., (L) GRANDVIEW DR., 3rd LOT ON RIGHT PAST BRANDYWINE LP.

SUBDIVISION GLENN RIDGE BLOCK / SECTION ____ LOT 54 LOT AREA 0.85 ACRES SITE CLASS. PS DESIGN FLOW 360 GPD L.T.A.R. 0.30 GPD/FT²

Septic Tank: 1,000 Gallons; STB 1012 Date 12-20-02
Pump Tank: ____ Gallons; PT ____ Date ____
Pump Make: ____ Model ____ Serial No. ____
Nitrification Field: No Fields 1 Square Feet EQ to 1,200 Linear Feet 200
No Lines 4@50' Trench Width 24" Max Trench Bottom Depth 36" Gravel Depth N/A


[X] New System [ ] Repair System Type: I, II, (III), IV, V, VI
System Description: 50% REDUCTION, GRAVITY
Repair System Description: LOW PRESSURE, 50% REDUC.
Maintenance Agreement Required: [ ] Yes [X] No

[X] House/Mod. Home No. Bedrooms 3
[ ] Mobile Home No. Bathrooms 2½
[ ] Business No. Employees ____
[ ] Other ____
[ ] Slab [X] Crawl Space [ ] Basement w/plumbing [ ] Basement wo/plumbing

Water Supply: [X] Individual [ ] Public [ ] Community
WELL

Comments/Conditions: (1) SYSTEM MUST BE 100' PLUS FROM ANY WELL, INCLUDING THE WELL ON THE LOT. (15A NCAC 18A.1956(9)) WELL MUST BE PLACED ON LOT MAINTAINING SETBACKS FROM SURROUNDING SEPTIC SYSTEMS. (2) INSTALL SYSTEM USING 11 PANELS PER LINE (44 PANELS TOTAL). (3) WELL MUST BE PLACED IN PROPOSED LOCATION TO MAINTAIN SETBACKS.

INITIAL SITE SKETCH

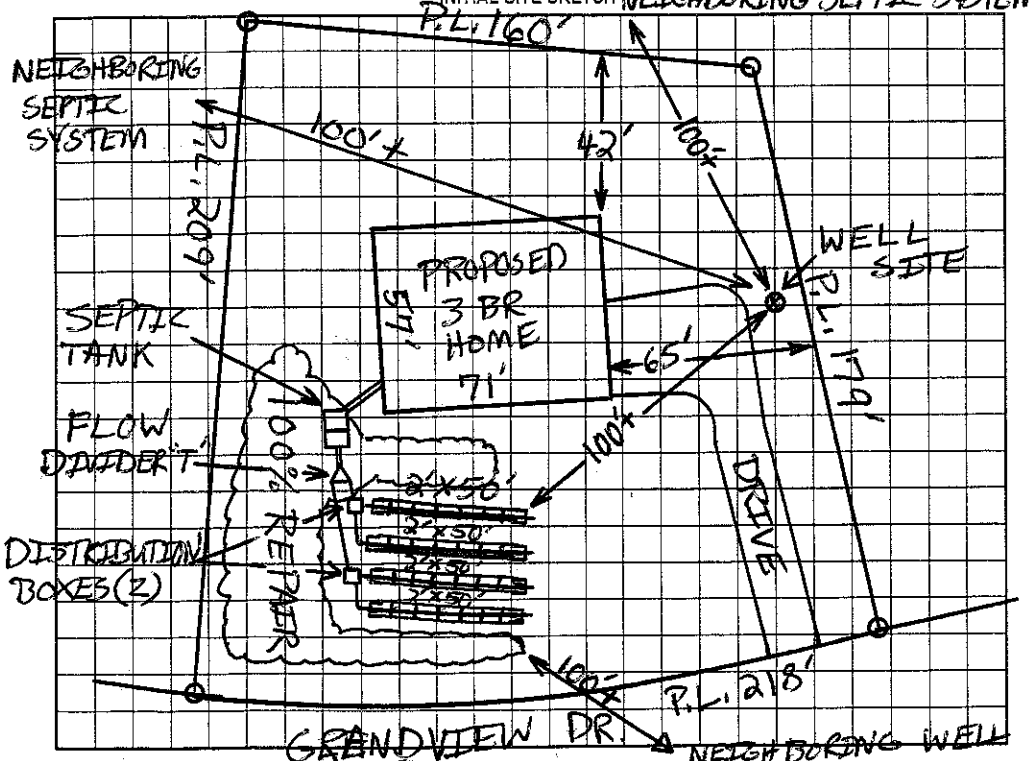

AS BUILT SKETCH

St. Market Tuff-Tite Filter Installed

Installed As Shown

For

Initial Site Sketch

Permit can be suspended or revoked if any false information is supplied toward securing the permit/any unauthorized changes are made to the site/any unauthorized changes are made in the installation of the system. Improvement Permit with plat valid without expiration. Improvement Permit with site plan valid for sixty months. Authorization to Construct is valid for a period equal to that of Improvement Permit – not to exceed sixty months.

Signed: [signature] date 1-27-03 Installed by: Steve Jordan

Improvement Permit by: Patrick Mitchell date 01/16/03 Operation Permit by: William O. Lehman date 7-8-03

Authorization to Construct by: Patrick Mitchell date 01/16/03 Existing System Inspection by: ____ date ____

HEALTH DEPT. COPY: WHITE OWNER COPY (FINAL): YELLOW OWNER COPY (INITIAL): PINK