IREDELL COUNTY HEALTH DEPARTMENT

CI STATESVILLE 704-878-5305 MOORESVILLE 704-664-5281

IMPROVEMENT PERMIT / AUTHORIZATION TO CONSTRUCT / OPERATION PERMIT / EXISTING SYSTEM INSPECTION

PERMIT# 131983 PIN# 4723527090 DATE 11-23-05

OWNER OR CONTRACTOR Bob Huber PHONE: Business 704 872 0227 Home

ADDRESS 164 Grandview Dr.

LOCATION Buffalo Shoals South - left on Grandview Dr Lot on R

SUBDIVISION Glen Ridge BLOCK / SECTION 1 LOT 56 LOT AREA .863 Acre SITE CLASS PS DESIGN FLOW 360 L.T.A.R. .3

Septic Tank: 1000 Gallons; STB 1017 Date 2-1-06
Pump Tank: Gallons; PT Date
Pump Make: Model Serial No.
Nitrification Field: No Fields 1 Square Feet 1200 Linear Feet 300
No Lines 3 Trench Width 36" Max Trench Bottom Depth 24" Gravel Depth n/a

☒ New System ☐ Repair System Type: I II III IV V VI
System Description: 25% Reduction - Gravity
Repair System Description: 25% Reduction Gravity
Maintenance Agreement Required: ☐ Yes ☒ No


☒ House/Mod. Home No. Bedrooms 3
☐ Mobile Home No. Bathrooms
☐ Business No. Employees
☐ Other
☐ Slab ☐ Crawl Space ☐ Basement w/plumbing ☒ Basement wo/plumbing

Water Supply: ☒ Individual ☐ Public ☐ Community

Comments:/Conditions:
Install NO DEEPER THAN 24"

Comments:/Conditions:
Yellow Filter
ST marker
no risers

INITIAL SITE SKETCH

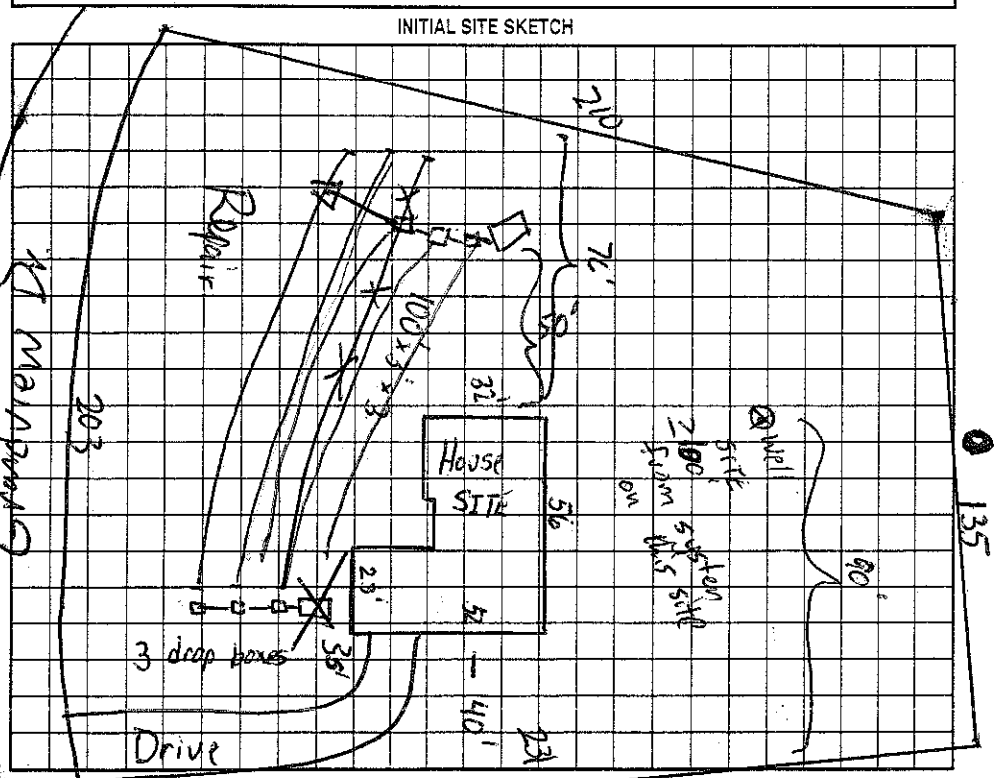

AS BUILT SKETCH

Permit can be suspended or revoked if any false information is supplied toward securing the permit/any unauthorized changes are made to the site/any unauthorized changes are made in the installation of the system. Improvement Permit with plat valid without expiration; Improvement Permit with site plan valid for sixty months. Authorization to Construct is valid for a period equal to that of Improvement Permit – not to exceed sixty months.

Signed: [signature] date 11-28-05 Installed by: David Kountz

Improvement Permit by: [signature] date 11-23-05 Operation Permit by: [signature] date 7-05-06

Authorization to Construct by: [signature] date 11-23-05 Existing System Inspection by: date

HEALTH DEPT. COPY: WHITE OWNER COPY (FINAL): YELLOW OWNER COPY (INITIAL): PINK