IREDELL COUNTY HEALTH DEPARTMENT

STATESVILLE 704-878-5305 MOORESVILLE 704-664-5281

IMPROVEMENT PERMIT / AUTHORIZATION TO CONSTRUCT / OPERATION PERMIT / EXISTING SYSTEM INSPECTION

PERMIT# 65843 PIN# 4723528587 DATE 3-31-99

OWNER OR CONTRACTOR Bobby Joe Dye PHONE: Business 872 9088 Home

ADDRESS 2470 Hickory Hwy

LOCATION Buffalo Shoales Turn Grantview on left before Brantly Wire

SUBDIVISION Glenn Rise BLOCK / SECTION LOT 26+27 LOT AREA 1.62 acres SITE CLASS PS DESIGN FLOW 360 L.T.A.R. 125

Septic Tank: 1000 Gallons; STB 1012 Date 2-8-99
Pump Tank: Gallons; PT Date
Pump Make: Model Serial No
Nitrification Field: No Fields 1 Square Feet 1080 Linear Feet 360
No Lines 5 Trench Width 36" Max Trench Bottom Depth 36" Gravel Depth

☑ New System ☐ Repair System Type: I II III IV V VI
System Description: Gravity 25% Rd.
Repair System Description: Pump To 25% Red
Maintenance Agreement Required: ☐ Yes ☑ No

☑ House/Mod. Home No. Bedrooms 3
☐ Mobile Home No. Bathrooms 2
☐ Business No. Employees
☐ Other

Slab ☑ Crawl Space ☐ Basement w/plumbing ☐ Basement wo/plumbing


Water Supply: ☑ Individual ☐ Public ☐ Community

Comments/Conditions:


Comments/Conditions

Replaces Permit issued To Allan Freese 5-14-97

INITIAL SITE SKETCH

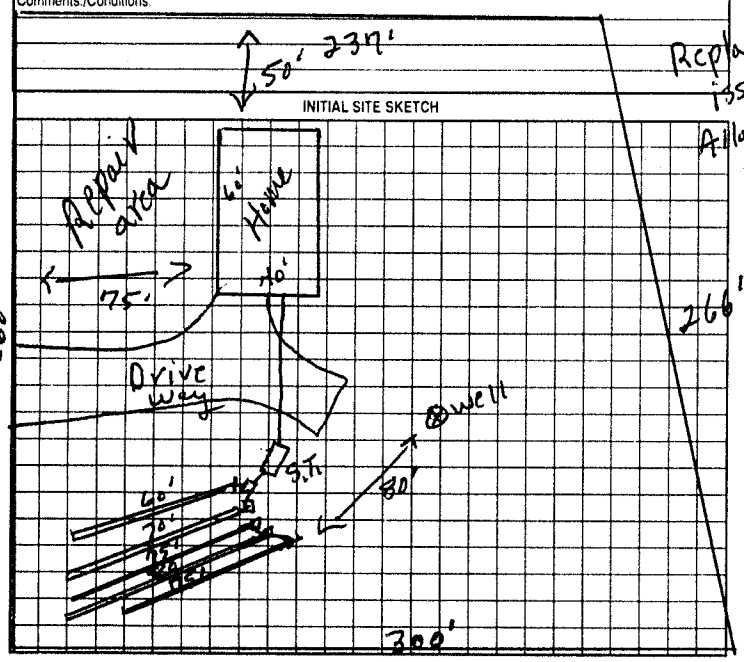

AS BUILT SKETCH

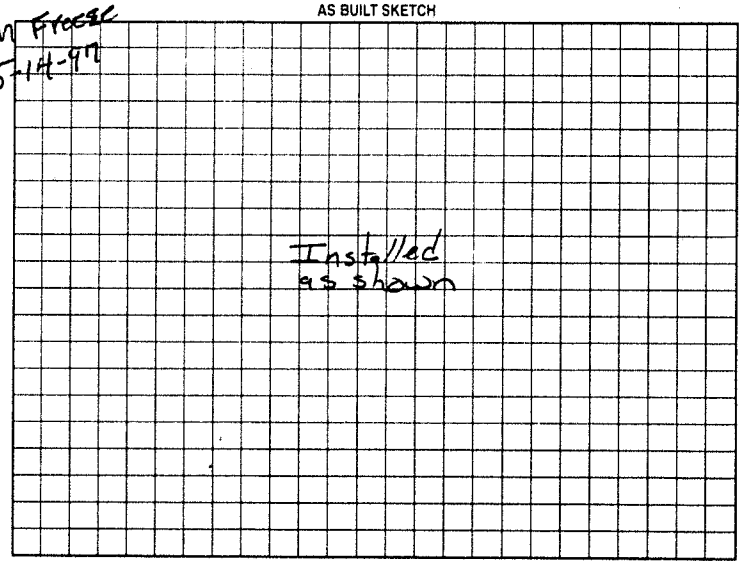

Permit can be suspended or revoked if any false information is supplied toward securing the permit/any unauthorized changes are made to the site/any unauthorized changes are made in the installation of the system. Improvement Permit with plat valid without expiration. Improvement Permit with site plan valid for sixty months. Authorization to Construct is valid for a period equal to that of Improvement Permit – not to exceed sixty months.

Signed: Bobby Joe Dye date 4-1-99 Installed by: Tommy Frye

Improvement Permit by: R. C. Moore date 3-31-99 Operation Permit by: M of C Off RS date 4-5-99

Authorization to Construct by: R. C. Moore date 3-31-99 Existing System Inspection by: date

HEALTH DEPT COPY: WHITE OWNER COPY (FINAL): YELLOW OWNER COPY (INITIAL): PINK