See Permit 166656 for RV cover addition. LT

IREDELL COUNTY HEALTH DEPARTMENT

STATESVILLE 704-878-5305 MOORESVILLE 704-664-5281

IMPROVEMENT PERMIT / AUTHORIZATION TO CONSTRUCT / OPERATION PERMIT / EXISTING SYSTEM INSPECTION

PERMIT# 31984 PIN# 4723528165 DATE 2-13-07

OWNER OR APPLICANT DAVID MEEHAN PHONE: Business 704 902-0086 Home 704-528-6378

ADDRESS 105 GALAX DR Statesville NC 28677

LOCATION BUFFALO SHOALS WEST (R) GRANDVIEW ON RT

SUBDIVISION COLLOW RIDGE BLOCK / SECTION 1 LOT 57 LOT AREA 1.78A SITE CLASS. PS DESIGN FLOW 360 L.T.A.R. .3

Septic Tank: 1000 G Gallons; STB 325 Date 4-2-07
Pump Tank: 1000 G Gallons; PT 307 Date 4-14-06
Pump Make: Zoeller Model N152 Serial No.
Nitrification Field: No Fields 1 Square Feet EQ=1200' Linear Feet 300'
No Lines 4x75 Trench Width 36" Max Trench Bottom Depth 20" Gravel Depth N/A

☒ New System ☐ Repair ☐ Expansion System Type: I II (III) IV V VI
System Description: Pump 0540 Recirculating
Repair System Description: 1 low pr. 55, 50'x12"
Maintenance Agreement Required: ☐ Yes ☒ No

☒ House/Mod. Home No. Bedrooms 3
☐ Mobile Home No. Persons 6
☐ Business No. Employees
☐ Other

Water Supply: ☒ Individual ☐ Public ☐ Community

☐ Gravity ☒ Pressure ☐ Slab ☒ Crawl Space ☐ Basement w/plumbing ☐ Basement wo/plumbing

Comments:/Conditions: (A) NOTE MAXIMUM TRENCH BOTTOM DEPTH (D) KEEP HOUSE OUT OF GRADING & BACKFILL FOR POSITIVE DRAINAGE REQMTS OR PERMIT WILL BE VOID. EXPLAINED TO BUILDER.

Comments:/Conditions: (E) CALL PRIOR TO INSTALLATION FOR SYSTEM SPECS & SYSTEM DESIGN IF NECESSARY.

Blue Filter

INITIAL SITE SKETCH

SEE ATTACHED SYSTEM DESIGN BY LORNE COOK, R.S.

AS BUILT SKETCH

Permit can be suspended or revoked if any false information is supplied toward securing the permit/any unauthorized changes are made to the site/any unauthorized changes are made in the installation of the system. Improvement Permit with plat valid without expiration. ☐ Improvement Permit with site plan valid for sixty months ☒ Authorization to Construct is valid for a period equal to that of Improvement Permit – not to exceed sixty months.

Signed: David Meehan date 2-14-07

Improvement Permit by: [signature] date 2-13-07

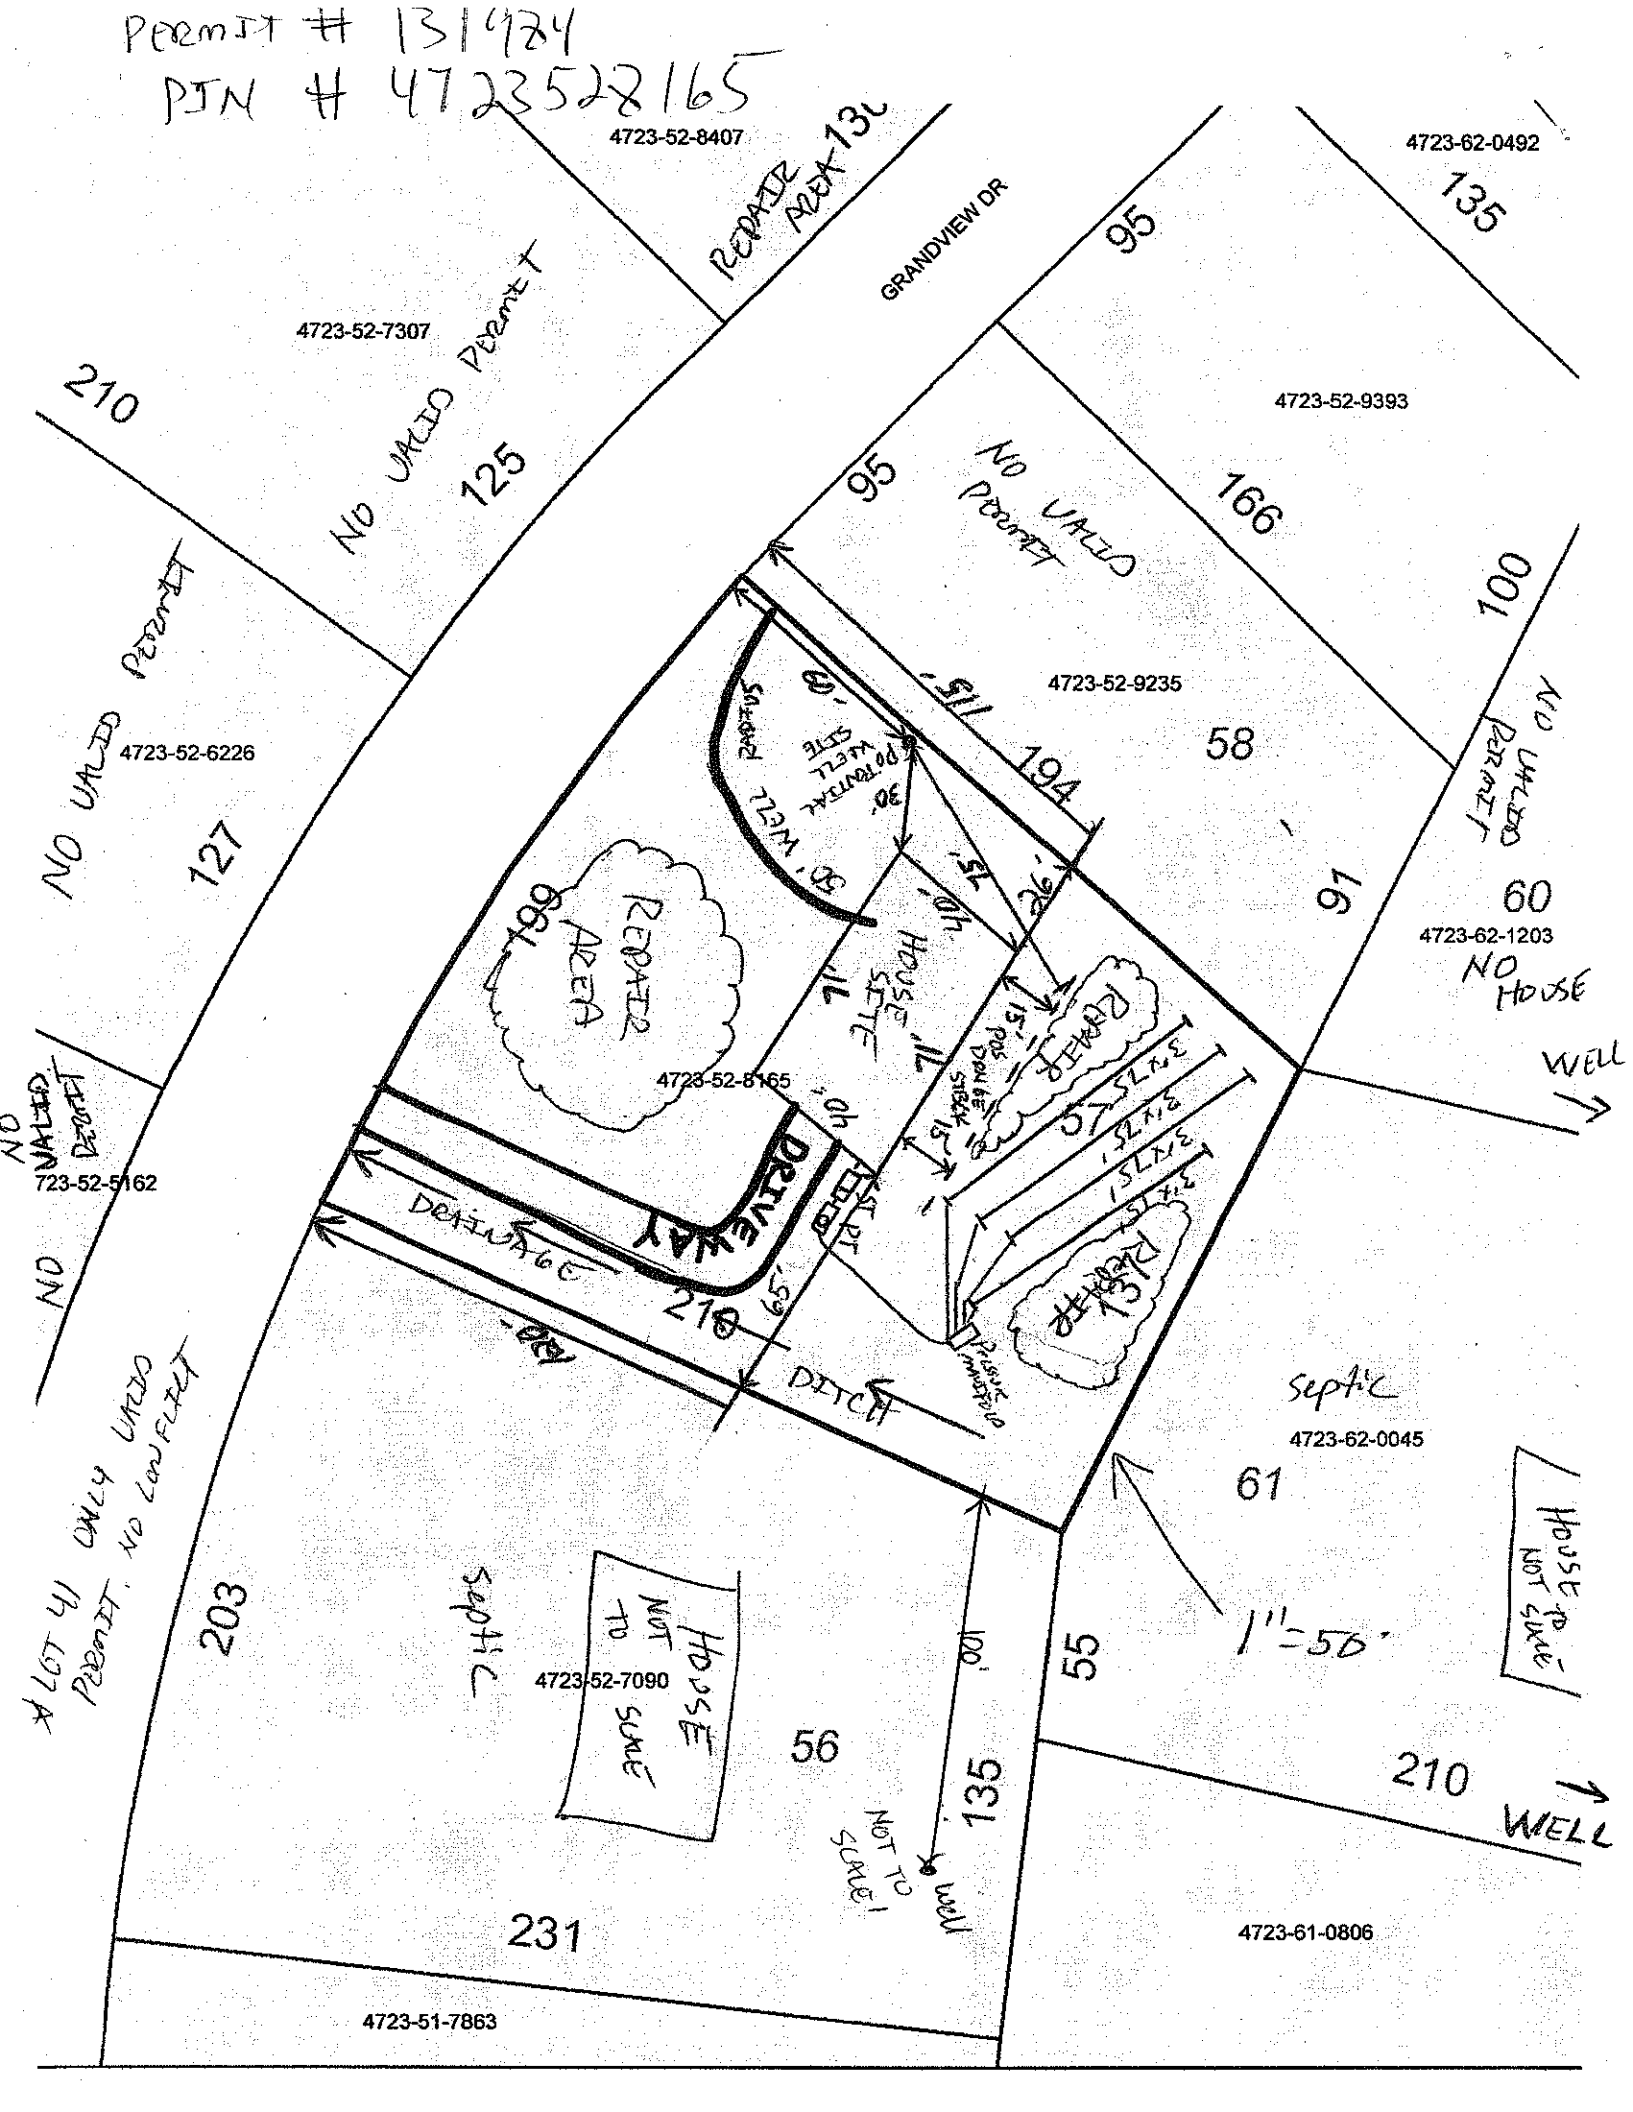
Authorization to Construct by: [signature] date 2-13-07

Installed by: Rawson Septic

Operation Permit by: [signature] date 7-5-07

Existing System Inspection by: date

HEALTH DEPT. COPY: WHITE OWNER COPY (FINAL): YELLOW OWNER COPY (INITIAL): PINK


Permit # 131424
PIN # 4723528165
4723-52-8407
4723-62-0492
REPAIR AREA 130
GRANDVIEW DR
95
135
4723-52-7307
210
NO VALID Permit
125
4723-52-9393
95
NO VALID Permit
166
100
NO VALID Permit
4723-52-9235
4723-52-6226
127
58
NO VALID Permit
60
4723-62-1203
NO HOUSE
199
REPAIR AREA
4723-52-8165
91
WELL
NO VALID Permit
4723-52-5162
DRIVEWAY
DRAINAGE
210
DITCH
REPAIR AREA
septic
4723-62-0045
61
A LOT 41 ONLY HAS PERMIT. NO LOT FILL
203
septic
HOUSE NOT TO SCALE
4723-52-7090
56
55
1"=50'
210
WELL
135
NOT TO SCALE!
well
231
4723-61-0806
4723-51-7863

See Permit 166656 for RV cover addition. LT

IREDELL COUNTY HEALTH DEPARTMENT

STATESVILLE 704-878-5305 MOORESVILLE 704-664-5281

IMPROVEMENT PERMIT / AUTHORIZATION TO CONSTRUCT / OPERATION PERMIT / EXISTING SYSTEM INSPECTION

PERMIT# 31984 PIN# 4723528165 DATE 2-13-07

OWNER OR APPLICANT DAVID MEEHAN PHONE: Business 704 902-0286 Home 704-528-6378

ADDRESS 105 GALAX DR Statesville NC 28677

LOCATION BUFFALO SHOALS WEST (E) GRANDVIEW ON RT

SUBDIVISION GLEN RIDGE BLOCK / SECTION 1 LOT 57 LOT AREA 1.78A SITE CLASS. PS DESIGN FLOW 360 L.T.A.R. .3

Septic Tank: 1000 G Gallons; STB 325 Date 4-2-07
Pump Tank: 1000 Gallons; PT 307 Date 4-14-06
Pump Make: Zoeller Model N152 Serial No.
Nitrification Field: No Fields 1 Square Feet EW=1200' Linear Feet 300'
No Lines 4x75 Trench Width 36" Max Trench Bottom Depth 20" Gravel Depth N/A

☒ New System ☐ Repair ☐ Expansion System Type: I II (III) IV V VI
System Description: Pump 25gpm Pressurized
Repair System Description: Low Press. 50'x1.20
Maintenance Agreement Required: ☐ Yes ☒ No

☒ House/Mod. Home ☐ Mobile Home ☐ Business ☐ Other
No. Bedrooms 3 No. Persons 6 No. Employees

Water Supply: ☒ Individual ☐ Public ☐ Community

☐ Gravity ☒ Pressure ☐ Slab ☒ Crawl Space ☐ Basement w/plumbing ☐ Basement wo/plumbing

Comments/Conditions: (A) NOTE MAXIMUM TRENCH BOTTOM DEPTH (D) KEEP HOUSE OUT OF GRADING & BACKFILL FOR POSITIVE DRAINAGE REQMTS OR PERMIT WILL BE VOID. EXPLAINED TO BUILDER.

Comments/Conditions: (E) CALL PRIOR TO INSTALLATION FOR SYSTEM SPECS & SYSTEM DESIGN IF NECESSARY.

Blue Filter

INITIAL SITE SKETCH

SEE ATTACHED SYSTEM DESIGN BY LORNE COOK, R.S.

AS BUILT SKETCH

Permit can be suspended or revoked if any false information is supplied toward securing the permit/any unauthorized changes are made to the site/any unauthorized changes are made in the installation of the system. Improvement Permit with plat valid without expiration. ☐ Improvement Permit with site plan valid for sixty months ☒ Authorization to Construct is valid for a period equal to that of Improvement Permit – not to exceed sixty months.

Signed: David Meehan date 2-14-07

Improvement Permit by: [signature] date 2-13-07

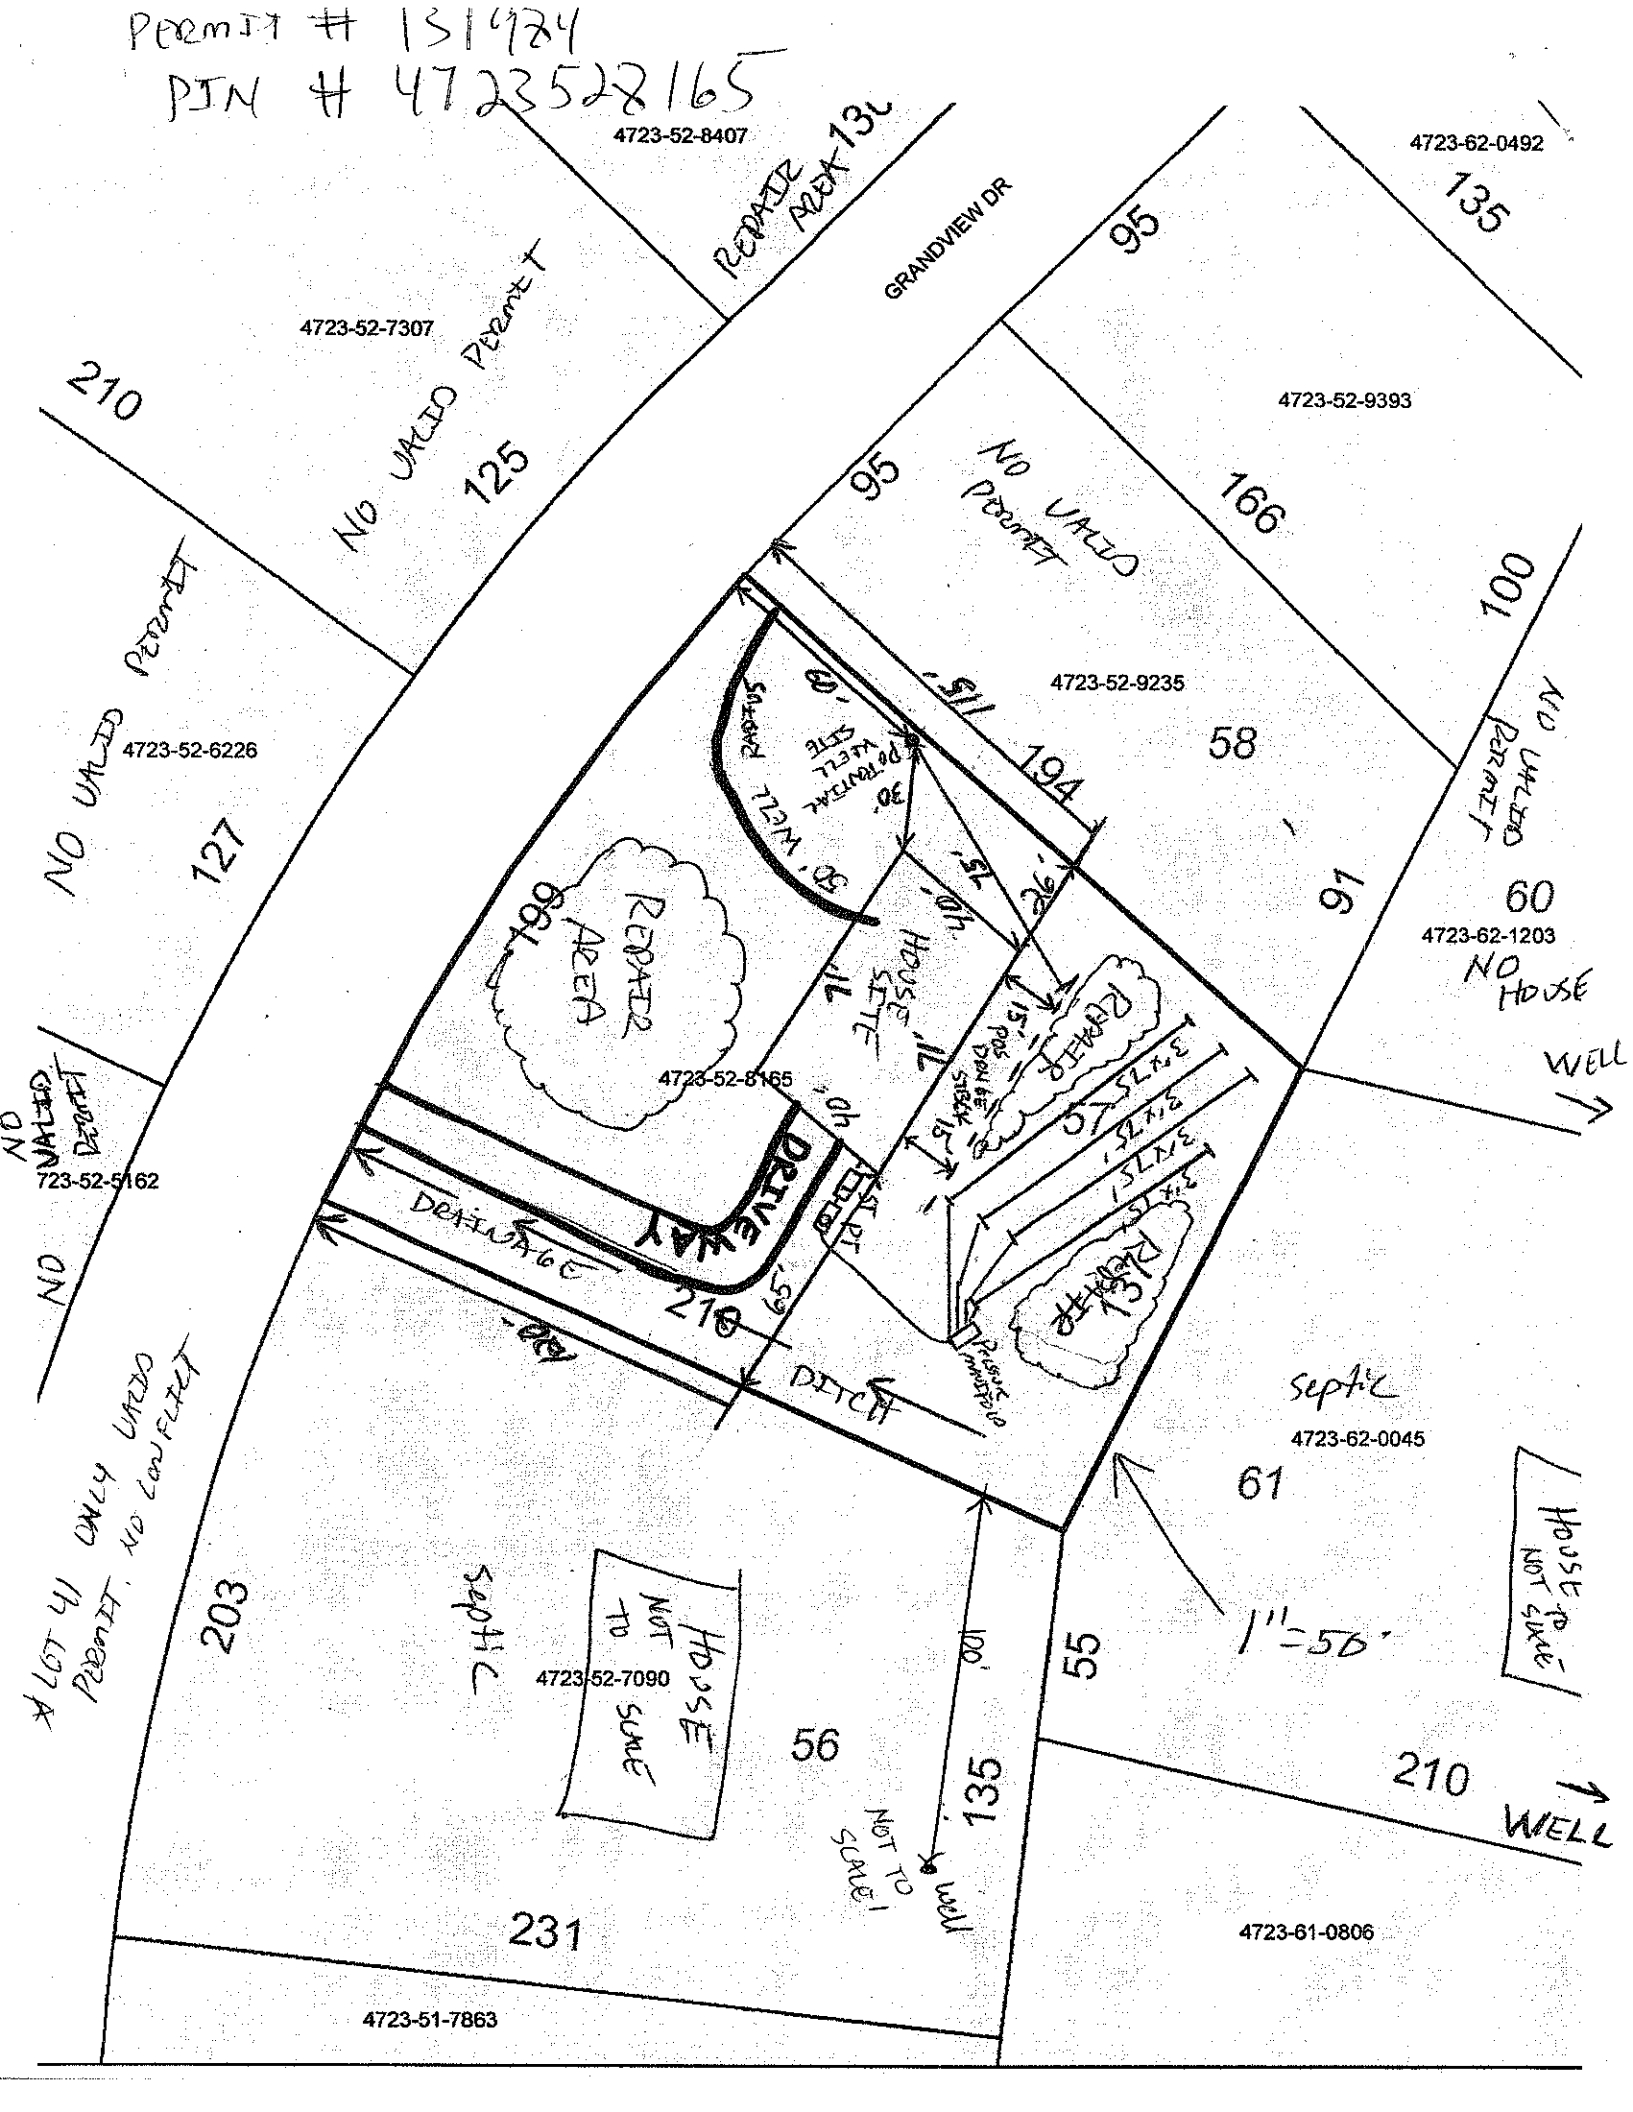
Authorization to Construct by: [signature] date 2-13-07

Installed by: Raven Septic

Operation Permit by: [signature] date 7-5-07

Existing System Inspection by: date

HEALTH DEPT. COPY: WHITE OWNER COPY (FINAL): YELLOW OWNER COPY (INITIAL): PINK


PERMIT # 151424
PIN # 4723528165
4723-52-8407
4723-62-0492
4723-52-7307
4723-52-9393
4723-52-6226
4723-52-9235
4723-52-8165
4723-62-1203
4723-62-0045
4723-52-7090
4723-61-0806
4723-51-7863
GRANDVIEW DR
REPAIR AREA
NO VALID PERMIT
DRIVEWAY
DRIVEWAY
DITCH
HOUSE SITE
PROPOSED WELL SITE
PROPOSED SEPTIC
SEPTIC
HOUSE TO BE NOT TO SCALE
WELL
NOT TO SCALE
1"=50'
ALOT 41 ONLY HAS PERMIT, NO CONFLICT
210
125
95
135
166
100
91
60
127
199
194
58
61
55
56
203
231
135
210
100
65'
75'
71'
10'
30'
15'
26'
NO HOUSE