IREDELL COUNTY HEALTH DEPARTMENT

LT

STATESVILLE 704-878-5305 MOORESVILLE 704-664-5281

IMPROVEMENT PERMIT / AUTHORIZATION TO CONSTRUCT / OPERATION PERMIT / EXISTING SYSTEM INSPECTION

PERMIT# 31984 PIN# 4723528165

OWNER OR APPLICANT DAVID MEEHAN DATE 2-13-07

ADDRESS 105 GALAX DR Statesville NC 28677 PHONE: Business 704 902-0986 Home 704-528-6378

LOCATION BUFFALO SHOALS WEST (R) GRANDVIEW DR RT

SUBDIVISION Cedar Ridge BLOCK / SECTION 1 LOT 57 LOT AREA 1.78A SITE CLASS PS DESIGN FLOW 360 L.T.A.R. .3

Septic Tank: 1250 Gallons; STB 325 Date 4-3-07

Pump Tank: 1000 Gallons; PT 302 Date 4-14-06

Pump Make: Zoeller Model N152 Serial No.

Nitrification Field: No Fields 1 Square Feet EQ=1200' Linear Feet 300'

No Lines 4x75 Trench Width 36" Max Trench Bottom Depth 20"

☒ New System ☐ Repair ☐ Expansion System Type: I II (III) IV V VI

System Description: Pump 2540 Recirculate

Repair System Description: Low Press, 50'x2"

Maintenance Agreement Required: ☐ Yes ☒ No

☒ House/Mod. Home No. Bedrooms 3

☐ Mobile Home No. Persons 6

☐ Business No. Employees

☐ Other

Water Supply: ☒ Individual ☐ Public ☐ Community

Gravel Depth N/A ☐ Gravity ☒ Pressure ☐ Slab ☒ Crawl Space ☐ Basement w/plumbing ☐ Basement wo/plumbing

Comments:/Conditions: (A) NOTE MAXIMUM TRENCH BOTTOM DEPTH (I) KEEP HOUSE OUT OF GROUND & BACKFILL FOR POSITIVE DRAINAGE AWAY FROM OR PERMIT WILL BE VOID. EXPLAINED TO BUILDER.

Comments:/Conditions: (E) CALL PRIOR TO INSTALLATION FOR SYSTEM SPECS & SYSTEM DESIGN IF NECESSARY.

Blue Filter

INITIAL SITE SKETCH

SEE ATTACHED SYSTEM DESIGN BY LORNE COOK, R.S.

AS BUILT SKETCH

Location of the proposed R.V. Cover addition does not appear to impact the existing on-site septic system.**NOTE: Keep 5'+ from any portion of Syst. System.

REHS

Date: 19 May 2011

ICHD-Environmental Health Division

Permit can be suspended or revoked if any false information is supplied toward securing the permit/any unauthorized changes are made to the site/any unauthorized changes are made in the installation of the system. Improvement Permit with plat valid without expiration. ☐ Improvement Permit with site plan valid for sixty months ☒ Authorization to Construct is valid for a period equal to that of Improvement Permit – not to exceed sixty months.

Signed: David Meehan date 2-14-07

Improvement Permit by: date 2-13-07

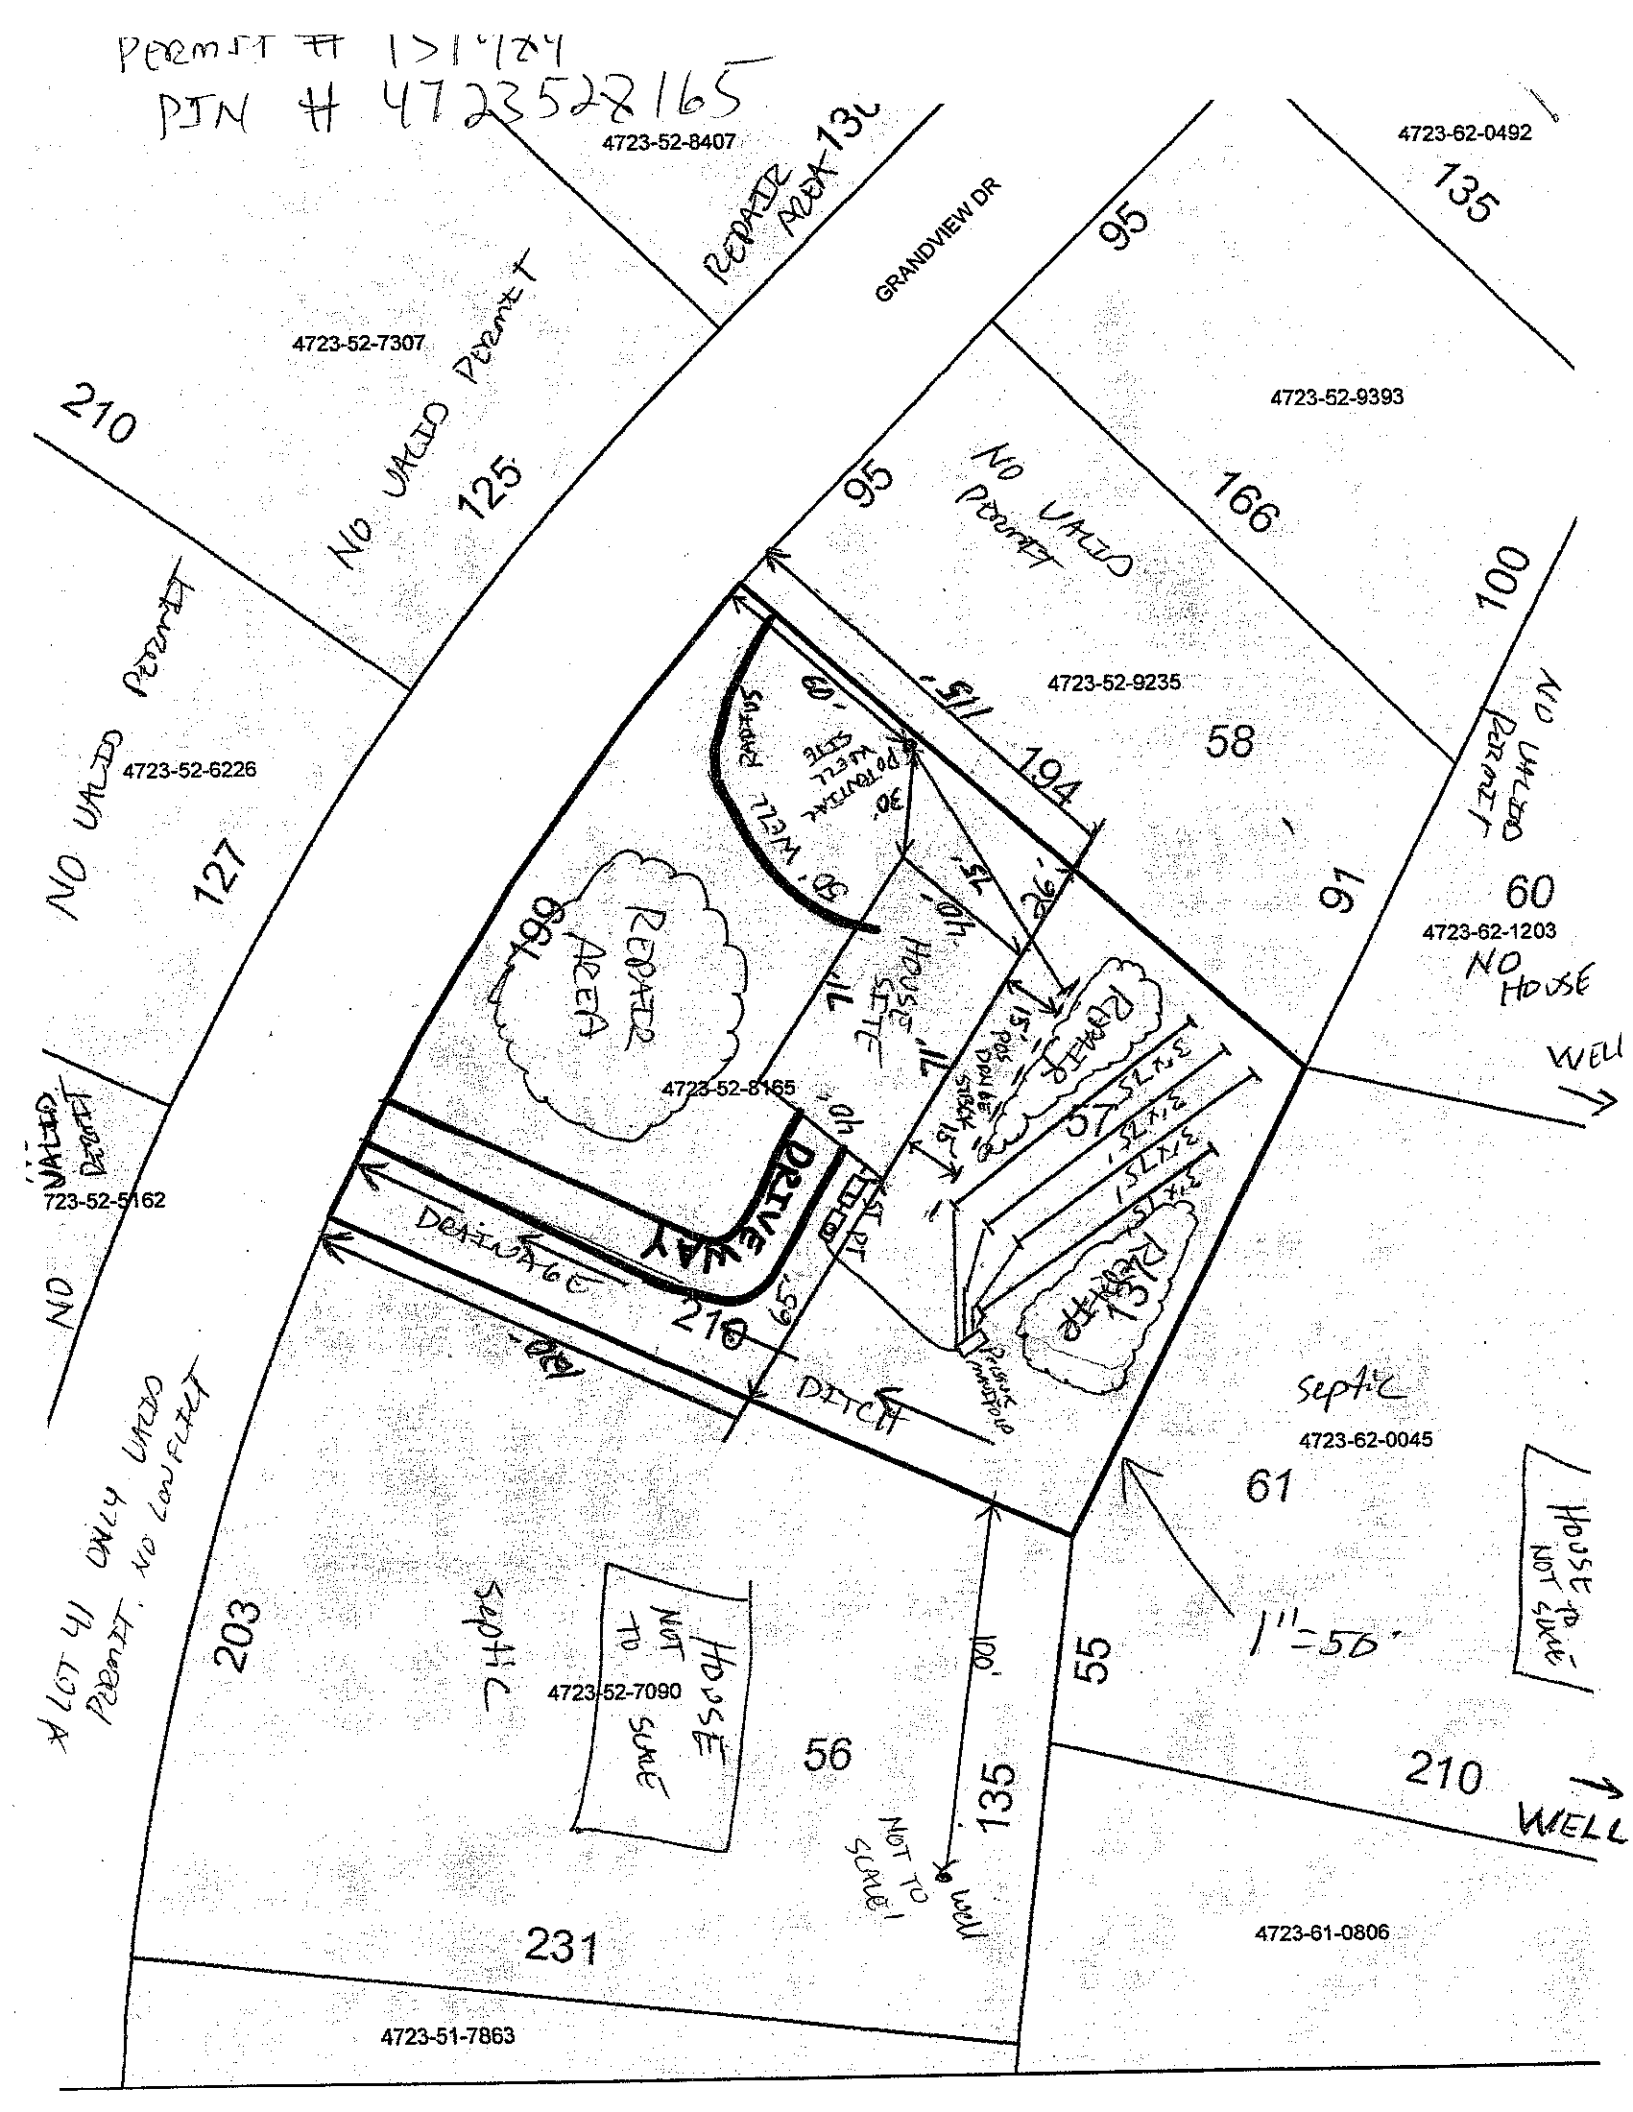
Authorization to Construct by: date 2-13-07

Installed by: Raven Septic

Operation Permit by: date 7-5-07

Existing System Inspection by: date

HEALTH DEPT. COPY: WHITE OWNER COPY (FINAL): YELLOW OWNER COPY (INITIAL): PINK


Permit # 131784
PIN # 4723528165
4723-52-8407
4723-62-0492
4723-52-7307
4723-52-9393
4723-52-9235
4723-52-6226
4723-52-8165
4723-62-1203
4723-62-0045
4723-52-7090
4723-61-0806
4723-51-7863
GRANDVIEW DR
REPAIR AREA
NO VALID Permit
PROPOSED WELL SITE
30' RADIUS
HOUSE SITE
DRIVEWAY
DRIVEWAY
DITCH
SEPTIC
HOUSE NOT TO SCALE
WELL
NOT TO SCALE
A LOT 41 ONLY VALID PERMIT. NO LONGER
1" = 50'