IREDELL COUNTY HEALTH DEPARTMENT

STATESVILLE 704-878-5305 MOORESVILLE 704-664-5281

IMPROVEMENT PERMIT / CERTIFICATE OF COMPLETION / OPERATION PERMIT / EXISTING SYSTEM INSPECTION

PROPERTY DESCRIPTION NO. 25961 1244H DATE 1-23-97 TAX MAP NO. 4723-53-8198 Watershed: ☐ Yes ☑ No

OWNER OR CONTRACTOR S. W. Nash Jr. PHONE: Business _____ Home 872-3680

ADDRESS 3022 Hickory Hwy Sta.

LOCATION Buffalo Shoales Rd TR Grandview Dr. before end on left.

SUBDIVISION Glenn Ridge BLOCK / SECTION _____ LOT 22 LOT AREA 2 acres SITE CLASS. A5 DESIGN FLOW 360 L.T.A.R. 13

Septic Tank: 1000 Gallons; STB 1012 Date 5-6-98

Pump Tank: 1000 Gallons; PT 17 Date 1-3-98

Pump Make: Gaults Model 3885 Serial No. DE 0772 H

Nitrification Field: No Fields 1 Square Feet 900 Linear Feet 300

No Lines 4 Trench Width 36" Max Trench Bottom Depth 24" Gravel Depth N/A

☑ New System ☐ Repair System Type: I, II, III, IV, V, VI

System Description: Pump To chambers

Repair System Description: Pump To Panels

Maintenance Agreement Required: ☐ Yes ☑ No

☑ House/Mod. Home No. Bedrooms 3

☐ Mobile Home No. Bathrooms 2

☐ Business No. Employees ____

☐ Other _____

☐ Slab ☑ Crawl Space ☐ Basement w/plumbing ☐ Basement wo/plumbing


Water Supply: ☑ Individual ☐ Community ☐ Public

Comments: See Attached Sheets for Pump Tank Set up requirements pump size pressure manifold & clean-out sheets which are part of this permit.


Comments: + 1/2 basement

Inspected Drain Lines S.T. & P.T. 7-8-98 Jem

INITIAL SITE SKETCH

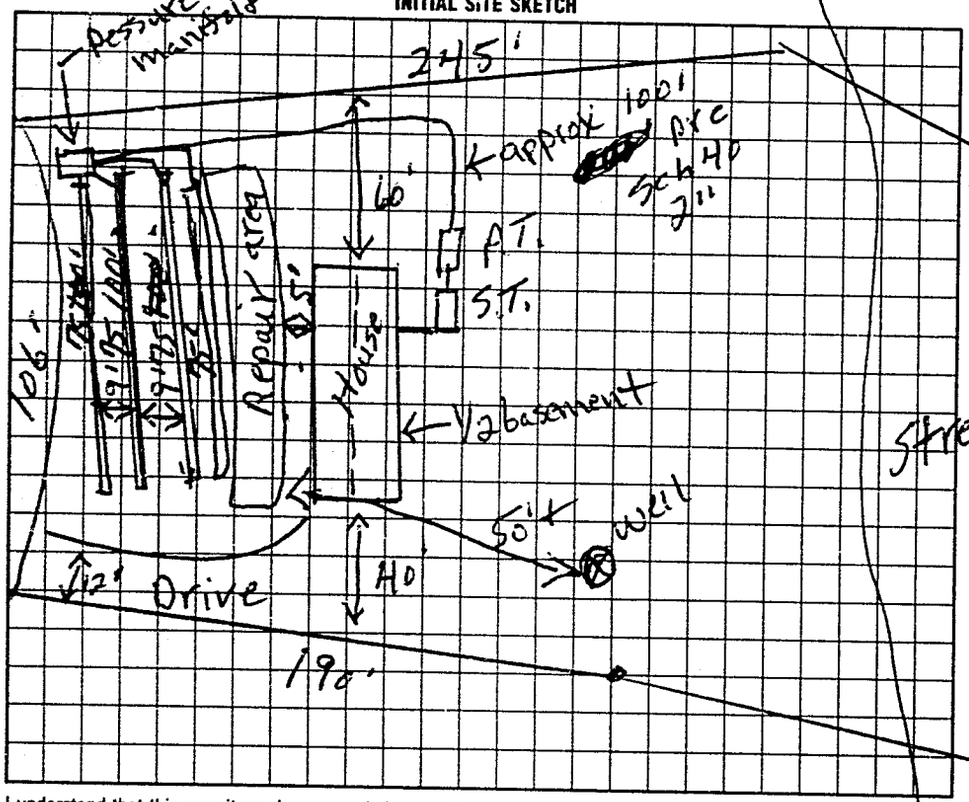

AS BUILT SKETCH

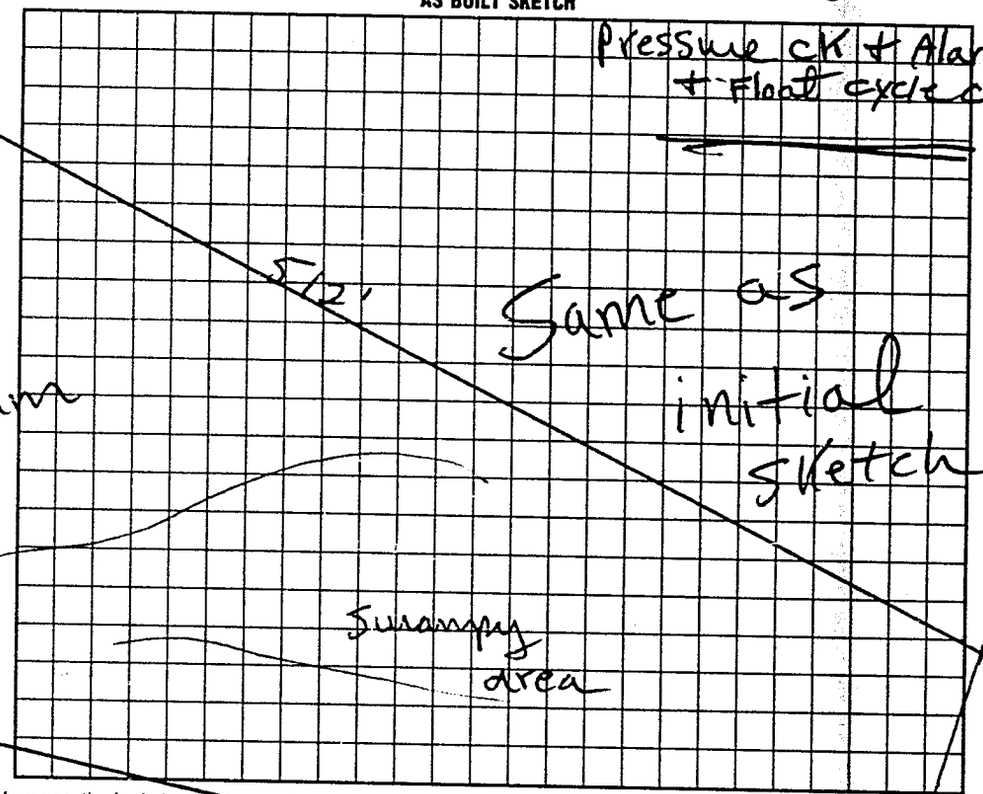

I understand that this permit can be suspended or revoked if any false information is supplied toward securing the permit/any unauthorized changes are made to the site/any unauthorized changes are made in the installation of the system. Improvement Permit is valid for 60 months from date of issuance.

Signed: Stephen Nash Jr.

Improvement Permit by: J.C. Moore date 1-23-97

Authorization to Count Existing System Inspection by: J.C. Moore date 1-23-97

Installed by: David Yountz

Certificate of Completion by: _____ date _____

Operation Permit by: J.C. Moore date 7-24-98

HEALTH DEPT COPY WHITE INSPECTION COPY (FINAL) GREEN OWNER COPY (FINAL) YELLOW INSPECTION COPY (INITIAL) PINK OWNER COPY (INITIAL) GOLD

Authorization to Count Expires 60 mos from issue