CI

IREDELL COUNTY HEALTH DEPARTMENT

STATESVILLE 704-878-5305 MOORESVILLE 704-664-5281

IMPROVEMENT PERMIT / AUTHORIZATION TO CONSTRUCT / OPERATION PERMIT / EXISTING SYSTEM INSPECTION

PERMIT# 095576 PIN# 4723 53 9042 DATE 4/18/01

OWNER OR CONTRACTOR MARK DUNNING PHONE: Business Home (704) 528-9153

ADDRESS 126 ANCHOR LN., TROUTMAN, NC 28166

LOCATION BUFFALO SHOALS RD. (R) GRANDVIEW DR. ON (L)

SUBDIVISION GLEN RIDGE BLOCK / SECTION F LOT 23 LOT AREA .93 Ac. SITE CLASS PS DESIGN FLOW 360 GPD L.T.A.R. .30

Septic Tank: 1000 Gallons: STB 1007 Date 9-22-11
Pump Tank: 1000 Gallons: PT 2114 Date 9-19-11
Pump Make: Hydromatic Model SHE 50A Serial No —
Nitrification Field: No Fields 1 Square Feet 1028 Linear Feet 300'
No Lines 3 Trench Width 3' Max Trench Bottom Depth 30" Gravel Depth N/A

☑ New System ☐ Repair System Type: I. II. (III) IV. V. VI
System Description: PUMP 25% REDUCTION
Repair System Description: PUMP 50% REDUCTION
Maintenance Agreement Required: ☐ Yes ☑ No
☐ Slab ☐ Crawl Space ☑ Basement w/plumbing ☐ Basement wo/plumbing


☑ House/Mod. Home No. Bedrooms 3
☐ Mobile Home No. Bathrooms 2
☐ Business No. Employees
☐ Other

Water Supply: ☑ Individual ☐ Public ☐ Community


Comments/Conditions: (1) INSTALL DRAINLINES UNIFORM AND ON CONTOUR.
(2) NO CUTTING OR FILLING OVER DRAINFIELD/REPAIR AREAS
(3) KEEP ALL DRAINS AWAY FROM DRAINFIELD/REPAIR AREAS
(4) MAINTAIN NOTED SETBACKS

Comments/Conditions: - Pressure Checked Okay
- 4" BIO Diffuser Chamber Installed
- Pump Tank Filter Installed

INITIAL SITE SKETCH

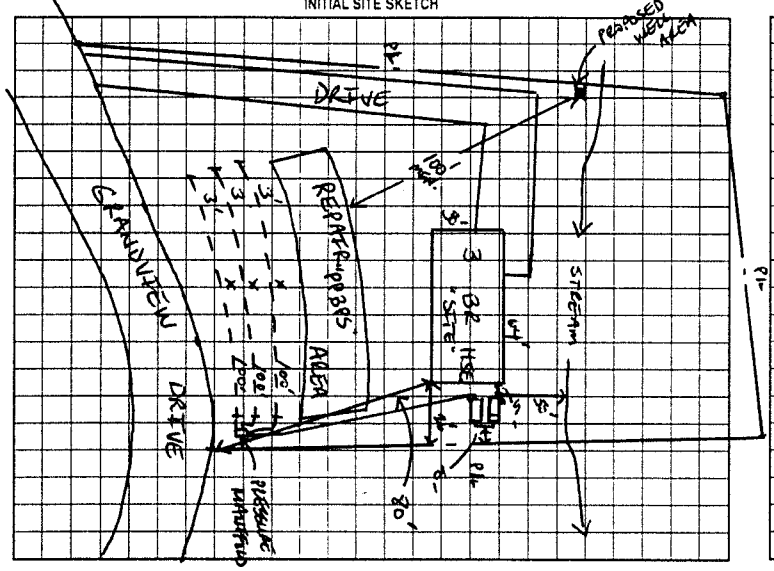

AS BUILT SKETCH

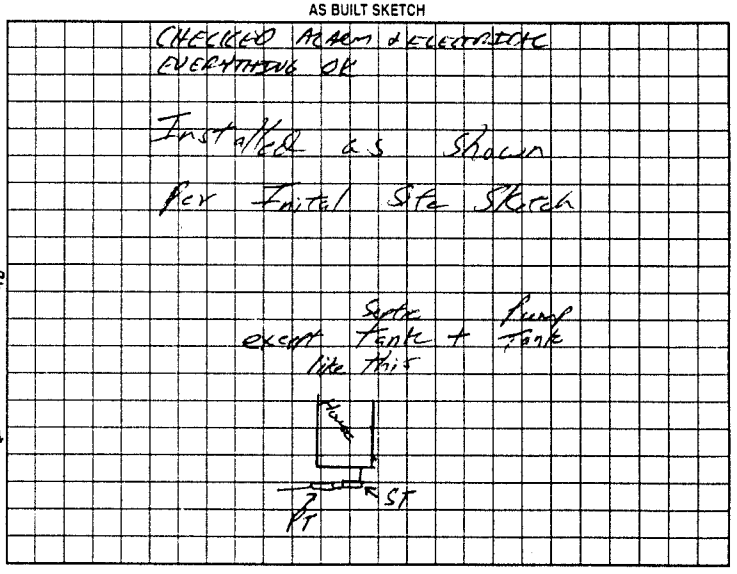

Permit can be suspended or revoked if any false information is supplied toward securing the permit/any unauthorized changes are made to the site/any unauthorized changes are made in the installation of the system. Improvement Permit with plat valid without expiration. Improvement Permit with site plan valid for sixty months. Authorization to Construct is valid for a period equal to that of Improvement Permit – not to exceed sixty months.

Signed: [signature] date 4/19/01 Installed by: Jody Jervis

Improvement Permit by: [signature] date 4/18/01 Operation Permit by: [signature] date 01-30-02

Authorization to Construct by: [signature] date 4/18/01 Existing System Inspection by: date

HEALTH DEPT COPY WHITE OWNER COPY (FINAL) YELLOW OWNER COPY (INITIAL) PINK