IREDELL COUNTY HEALTH DEPARTMENT

STATESVILLE 704-878-5305 MOORESVILLE 704-664-5281

IMPROVEMENT PERMIT / CERTIFICATE OF COMPLETION / OPERATION PERMIT / EXISTING SYSTEM INSPECTION

PROPERTY DESCRIPTION NO. 2140 DATE 8-7-95 TAX MAP NO. 6E-17-A-50 Watershed: ☐ Yes ☑ No

OWNER OR CONTRACTOR Hope Brothers PHONE: Business 872-4111 Home

ADDRESS 1120 Barkley Rd

LOCATION Buffalo Shoals Rd TR Airport Rd TL Parker Loop 2nd Ent. Delight Loop

SUBDIVISION Lakewood BLOCK / SECTION LOT 50 LOT AREA 1.65 acres SITE CLASS. PS DESIGN FLOW 360 L.T.A.R. 1.3 15+15+1/2

Septic Tank: 1000 Gallons; STB 794 Date 5-15-96

Pump Tank: Gallons; PT Date

Pump Make: Model Serial No.

Nitrification Field: No Fields 1 Square Feet 900 Linear Feet 300

No Lines 3 Trench Width 36" Max Trench Bottom Depth 36" Gravel Depth N/A

☑ New System ☐ Repair System Type: I, II, III, IV, V, VI

System Description: Chambered Graveless

Repair System Description: " "

Maintenance Agreement Required: ☐ Yes ☑ No

☑ House/Mod. Home No. Bedrooms 3

☐ Mobile Home No. Bathrooms 2

☐ Business No. Employees

☐ Other


☐ Slab ☑ Crawl Space ☐ Basement w/plumbing ☐ Basement wo/plumbing

Water Supply: ☐ Individual ☐ Community ☑ Public


Comments: Infiltrator System.

Comments: * System Installed in 4 lines

INITIAL SITE SKETCH

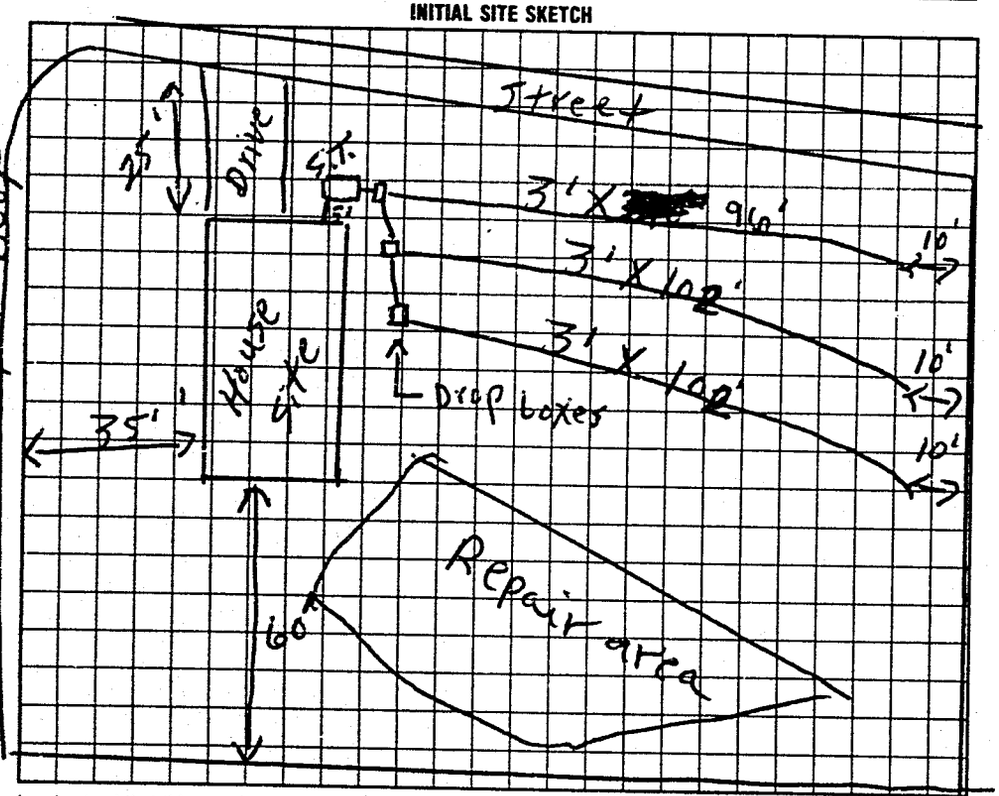

AS BUILT SKETCH

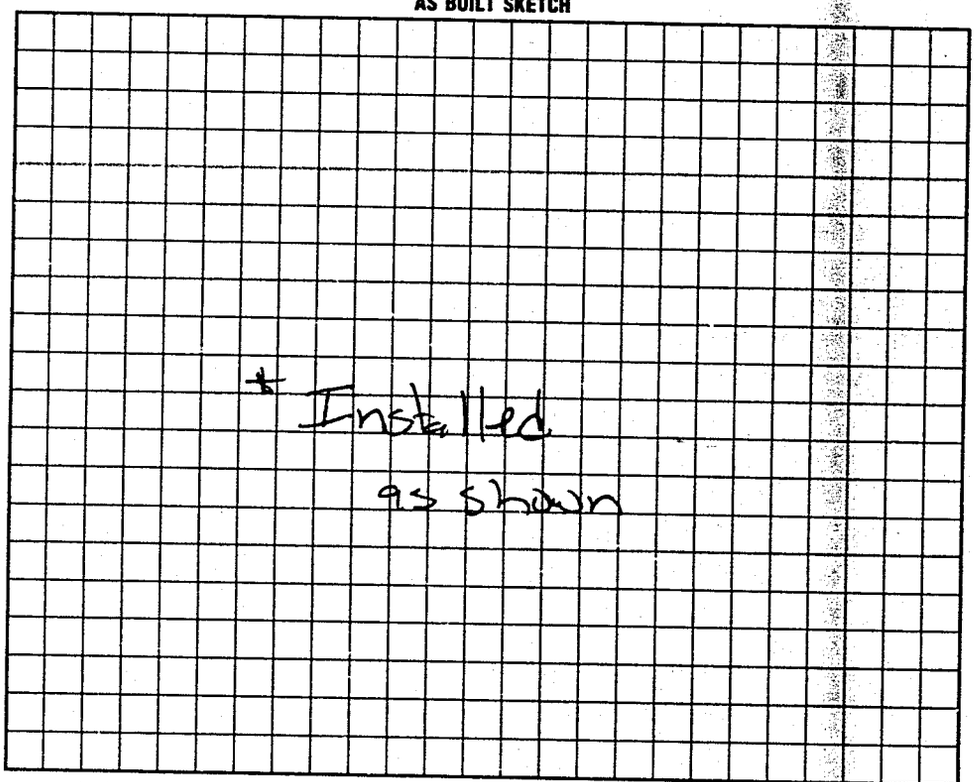

I understand that this permit can be suspended or revoked if any false information is supplied toward securing the permit/any unauthorized changes are made to the site/any unauthorized changes are made in the installation of the system.

Signed:

Improvement Permit by: E. C. Moore date

Existing System Inspection by: date

Installed by: James Hudler

Certificate of Completion by: date

Operation Permit by: Mat C Orf RS date 8-31-88

HEALTH DEPT. COPY: WHITE INSPECTION COPY (FINAL): GREEN OWNER COPY (FINAL): YELLOW INSPECTION COPY (INITIAL): PINK OWNER COPY (INITIAL): GOLD