IREDELL COUNTY HEALTH DEPARTMENT

STATESVILLE 704-878-5305 MOORESVILLE 704-664-5281

IMPROVEMENT PERMIT / AUTHORIZATION TO CONSTRUCT / OPERATION PERMIT / EXISTING SYSTEM INSPECTION

PERMIT# REPAIR PIN# 4723-55-7619 DATE 3-13-03

OWNER OR CONTRACTOR J.L. & RUTH HOPE PHONE: Business (704) 873-4111 Home

ADDRESS 261 DELIGHT LOOP STATESVILLE, NC 28677

LOCATION US 70 WEST, TL AIRPORT ROAD TR PARKER'S LAKE LOOP, TL 2ND DELIGHT LOOP, 4TH HOUSE ON RIGHT

SUBDIVISION LAKEWOOD BLOCK / SECTION LOT 53 LOT AREA 100' x 200' SITE CLASS. PS DESIGN FLOW 360 L.T.A.R. EXISTING

Septic Tank: EXISTING Gallons: STB Date

Pump Tank: Gallons: PT Date

Pump Make: Model Serial No.

Nitrification Field: No Fields 1 Square Feet EQ. TO 600 linear Feet 150

No Lines TWO Trench Width 36" Max Trench Bottom Depth 36" Gravel Depth NA

☐ New System ☑ Repair System Type: I, II, III, IV, V, VI

System Description: 25% REDUCTION

Repair System Description: GRAVITY

Maintenance Agreement Required: ☐ Yes ☑ No

☑ House/Mod. Home No. Bedrooms 3

☐ Mobile Home No. Bathrooms

☐ Business No. Employees

☐ Other


☑ Slab ☐ Crawl Space ☐ Basement w/plumbing ☐ Basement wo/plumbing

Water Supply: ☐ Individual ☑ Public ☐ Community


Comments:/Conditions: ① INSTALL SPEED LEVELER IN EXISTING DISTRIBUTION BOX, ② INSTALL NEW DROP BOXES AS SHOWN INTERCEPTING EXISTING DRAIN LINE ③ INSTALL 25% REDUCTION SYSTEM

Comments:/Conditions: THIS PERMIT SERVES AS "NOTICE OF VIOLATION", SYSTEM TO BE REPAIRED BY 4-13-03.

INITIAL SITE SKETCH

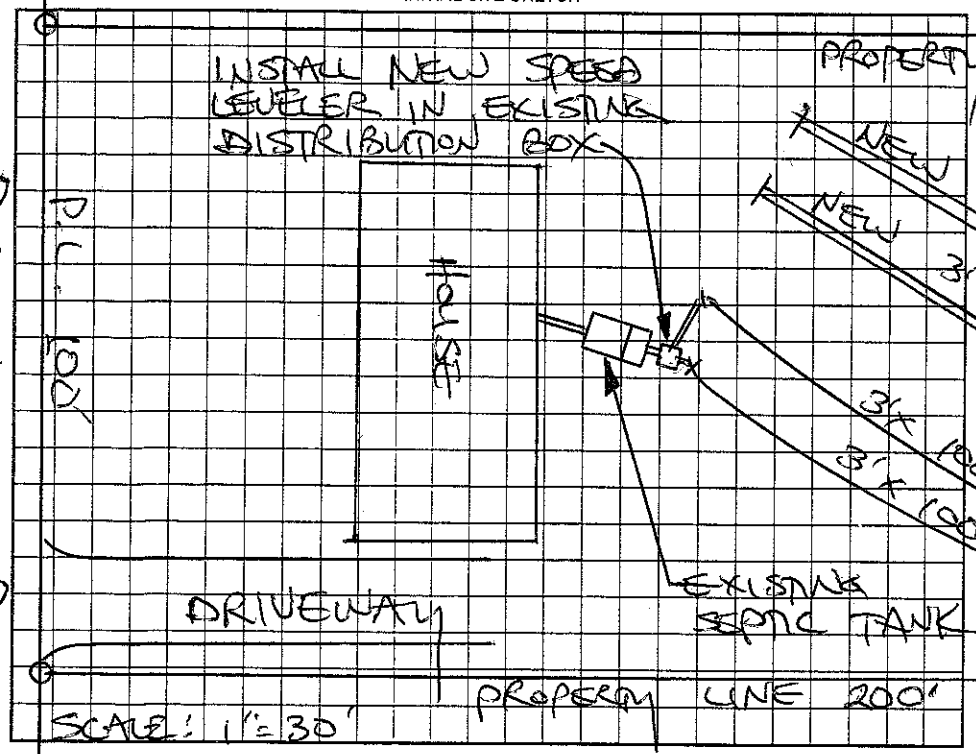

AS BUILT SKETCH

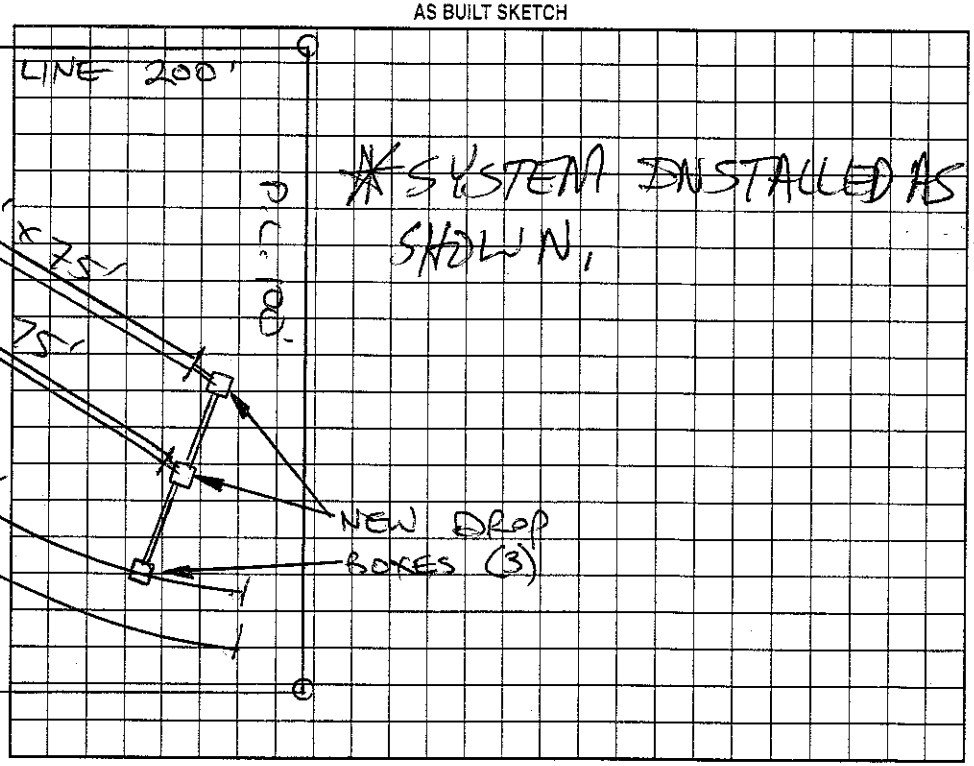

Permit can be suspended or revoked if any false information is supplied toward securing the permit/any unauthorized changes are made to the site/any unauthorized changes are made in the installation of the system. Improvement Permit with plat valid without expiration. Improvement Permit with site plan valid for sixty months. Authorization to Construct is valid for a period equal to that of Improvement Permit – not to exceed sixty months.

Signed: Jerry N. Wood Sr. date 3-13-03 Installed by: ARNEY DUNKING

Improvement Permit by: STEVE HEDRICK date 3-13-03 Operation Permit by: Patrick Mitchell date 04/17/03

Authorization to Construct by: STEVE HEDRICK date 3-13-03 Existing System Inspection by: date

HEALTH DEPT. COPY: WHITE OWNER COPY (FINAL): YELLOW OWNER COPY (INITIAL): PINK