IREDELL COUNTY HEALTH DEPARTMENT

STATESVILLE 704-878-5305 MOORESVILLE 704-664-5281

IMPROVEMENT PERMIT / CERTIFICATE OF COMPLETION / OPERATION PERMIT / EXISTING SYSTEM INSPECTION

PROPERTY DESCRIPTION NO. Repair DATE 6-22-93 TAX MAP NO. Repair

OWNER OR CONTRACTOR Mark Ashworth PHONE: Business Home

ADDRESS

LOCATION I40W TL Stamey Farm Rd. TL Hwy 70 TR Airport Rd. TR Park Lake Loop Rd.

SUBDIVISION Lakewood Estates BLOCK / SECTION LOT 16 LOT AREA SITE CLASS. Existing L.T.A.R. Existing

Water Supply: ☐ Individual ☐ Community ☑ Public —

Septic Tank: Existing Gallons; STB — Date —

Pump Tank: — Gallons; PT — Date —

Nitrification Field: No Fields 2 Square Feet 300 Linear Feet 100'

No Lines 2 Trench Width 6' Trench Depth 36" Gravel Depth 12"

☐ New System ☑ Repair System Type: I. II. IV. V. VI

System Description: Conventional, gravity

Repair System Description:

Maintenance Agreement Required: ☐ Yes ☑ No

☑ House/Mod. Home ☐ Mobile Home ☐ Business ☐ Other

No. Bedrooms No. Bathrooms No. Employees

Garbage Disposal: ☐ Yes ☐ No

Auto. Dishwasher: ☐ Yes ☐ No


Auto. Washing Machine: ☐ Yes ☐ No

Other


☐ Slab ☐ Crawl Space ☐ Basement w/plumbing ☐ Basement wo/plumbing

Comments When repair work was done, installers found that D-box on existing system was not feeding correctly. Installed speed levelers and only added 100' of drain line (6'x50'). We checked with home-owner and she said that would be OK.

INITIAL SITE SKETCH

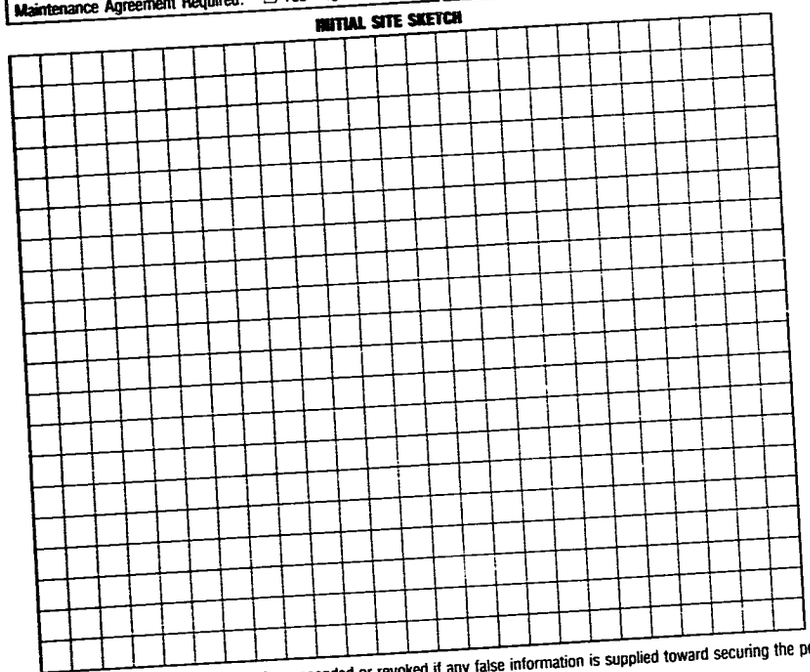

AS BUILT SKETCH

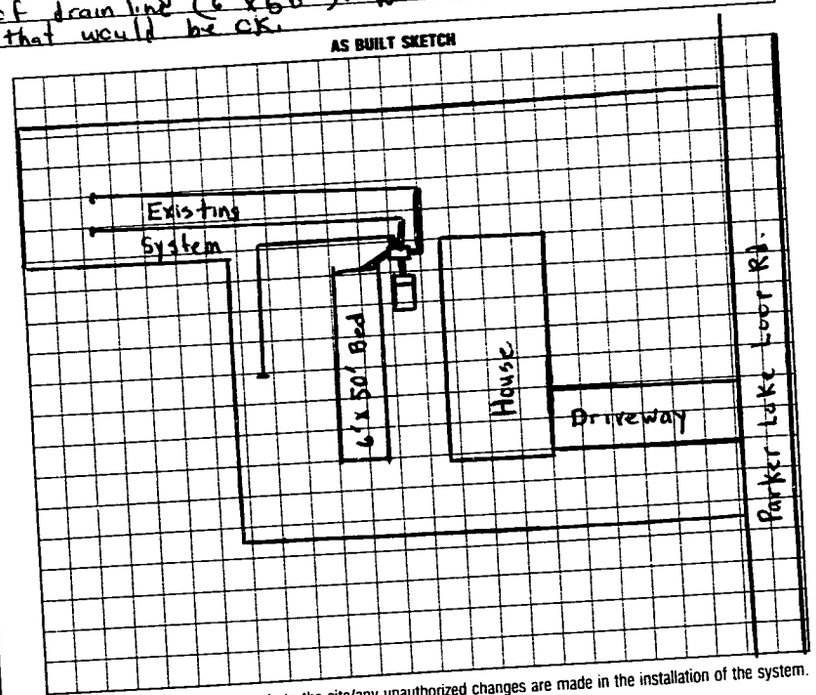

I understand that this permit can be suspended or revoked if any false information is supplied toward securing the permit/any unauthorized changes are made to the site/any unauthorized changes are made in the installation of the system. Improvement Permit is valid for 60 months from date of issuance.

Signed: Installed by: AAA Enterprises.

Improvement Permit by: J.C. Moore date 1-11-93 Certificate of Completion by: Michael L. Dennis date 6-22-93

Existing System Inspection by: date Operation Permit by: date

HEALTH DEPT. COPY: WHITE INSPECTION COPY (FINAL): GREEN OWNER COPY (FINAL): YELLOW INSPECTION COPY (INITIAL): PINK OWNER COPY (INITIAL): GOLD