IREDELL COUNTY HEALTH DEPARTMENT

STATESVILLE 704-878-5305 MOORESVILLE 704-664-5281

IMPROVEMENT PERMIT / CERTIFICATE OF COMPLETION / OPERATION PERMIT / EXISTING SYSTEM INSPECTION

PROPERTY DESCRIPTION NO. 20916-77869 DATE 6-12-95 TAX MAP NO. 6E-17-A-34 Watershed: ☐ Yes ☒ No

OWNER OR CONTRACTOR Hope Brothers PHONE: Business 872-4111 Home

ADDRESS 1120 Barkley Rd. Statesville, N.C. 28677

LOCATION I40W TL Stamey Farm Rd TL Hwy 70 TR Airport Rd TR Parker Lake Loop [(2nd) Entrance] FL 2nd Rd on L 3rd lot in R-

SUBDIVISION Lakewood Estates BLOCK / SECTION LOT 34 LOT AREA 100' x 150' SITE CLASS. P.S. DESIGN FLOW 360 L.T.A.R. .3gpd/ft2

Septic Tank: 1000 Gallons; STB 774 Date 5-15-94

Pump Tank: — Gallons; PT — Date —

Pump Make: — Model — Serial No. —

Nitrification Field: No Fields 1 Square Feet equivalent to 1200 Linear Feet 380'

No Lines 3 Trench Width 36" Max Trench Bottom Depth 24-30" Gravel Depth N/A

☒ New System ☐ Repair System Type: I, II, III, IV, V, VI

System Description: Chambered graveless System

Repair System Description: " "

Maintenance Agreement Required: ☐ Yes ☒ No

☒ House/Mod. Home ☐ Mobile Home ☐ Business ☐ Other

No. Bedrooms 3 No. Bathrooms 2 No. Employees


Water Supply: ☐ Individual ☐ Community ☒ Public

☐ Slab ☒ Crawl Space ☐ Basement w/plumbing ☐ Basement wo/plumbing

Comments: Install Chambered Graveless System. Keep line on contour. Keep system 10' from all property lines, 5' from foundation of home, and 10' from water line. Bring in enough sand to fill in around vents or louvers on chambers. NOTE Repair, partial pump, partial gravity chambered graveless system.

Comments: Note - Did not use drop Boxes - gm

INITIAL SITE SKETCH

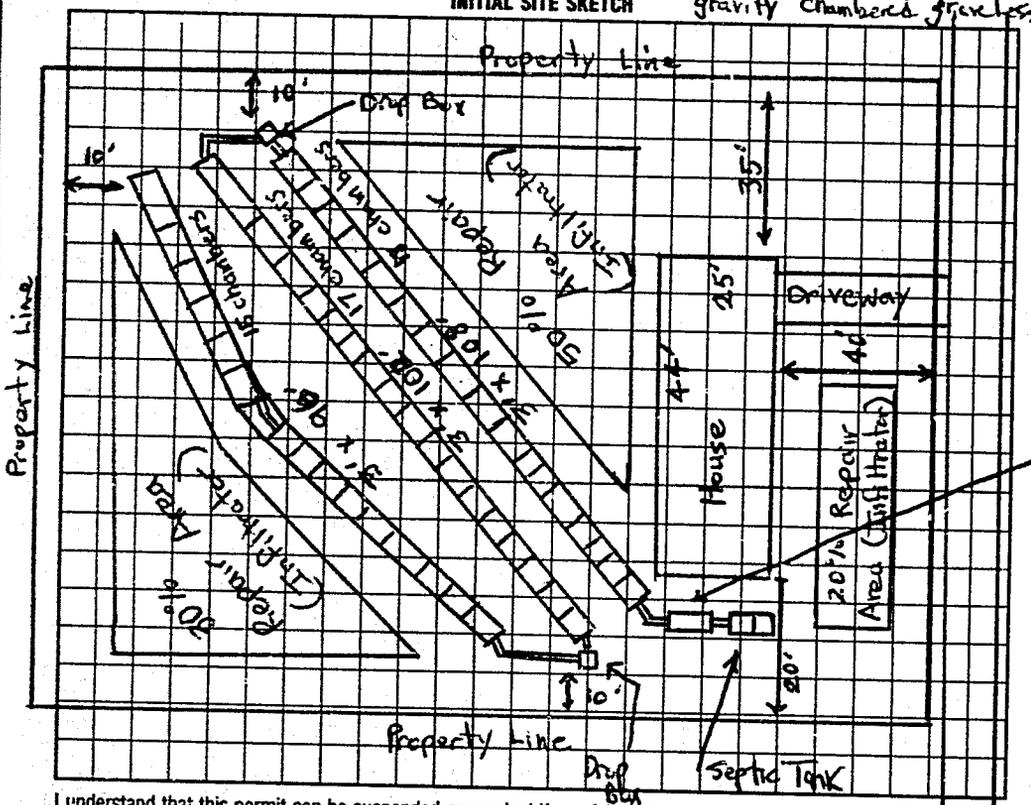

AS BUILT SKETCH

(50 chambers total)

Need To keep all Construction Traffic off system.

Installed as shown

I understand that this permit can be suspended or revoked if any false information is supplied toward securing the permit/any unauthorized changes are made to the site/any unauthorized changes are made in the installation of the system. Improvement Permit is valid for 60 months from date of issuance.

Signed: John C. Hope

Improvement Permit by: Michael J. Dennis date 6-12-95

Existing System Inspection by: date

Installed by: James Hudler

Certificate of Completion by: date

Operation Permit by: [illegible] date 8-29-98

HEALTH DEPT. COPY: WHITE INSPECTION COPY (FINAL): GREEN OWNER COPY (FINAL): YELLOW INSPECTION COPY (INITIAL): PINK OWNER COPY (INITIAL): GOLD