1147.

IREDELL COUNTY HEALTH DEPARTMENT

Duplicate

36531

(SEPTIC TANK) IMPROVEMENTS PERMIT AND CERTIFICATE OF COMPLETION
(Ground Absorption Sewage Disposal System -- G. S. Chapter 130-Article 13C)

OWNER OR CONTRACTOR J.L. HOPE

PHONE: Business _____ Home _____ DATE 8-6-90 PERMIT NO 6E-17-A-20.

LOCATION Lincoln Co. off S. Hwy 150 Shiloh Rd. - T.L. on 1st str. on (R.) (Parker Lp)

SUBDIVISION NAME LAKEWOOD ESTATES. LOT NO. 20 S. R. No. _____ SECTION OR BLOCK NO. _____


House ( ) Mobile Home ( ) Business ( ) Other _____

No. Bedrooms 3 No. Bathrooms 1.5

Garbage Disposal Unit Yes ( ) No ( )
Auto. Dishwasher Yes ( ) No ( )
Auto. Wash. Machine Yes ( ) No ( )
Site Suitable Yes ( ) No ( )
Lot Area 102' x 150'

Character & Formity of Soil Sandy Loam
Percolation Rate Good
Topography Level
Depth to Water Table 10'
Rock or other impervious formations None encountered.

_____ Basement with Plumbing _____ Basement without Plumbing ✓ No Basement

 

Plan of System

Size of Tank 1000 Gals.
Nitrification Field:
No. of Lines 3
Sq. Ft. 720 Linear Ft. 240
Depth of Stone in Lines 12"
Water Supply: Individual ( )
Public ( )

Installed by Hope Bros.

I understand and agree to install septic tank system as specified on this Improvements Permit.

Signed: _____

IMPROVEMENTS PERMIT BY Steve Brown

COMMENTS: Plumbing pipe from house to tank checked.

CERTIFICATE OF COMPLETION BY Steve Brown

EXISTING SYSTEM CHECKED BY: _____ DATE 8-16-90

CONSTRUCTION MUST COMPLY WITH ALL OTHER APPLICABLE STATE AND LOCAL REGULATIONS. DATE _____

Permit is VOID if any unauthorized changes are made in installation of system and/or if any false information is supplied in making Improvements Permit.

Health Dept. Copy: White Inspection Dept. Copy: Yellow Sanitarian's Copy: Pink Owner's Copy: Gold