08466

IREDELL COUNTY HEALTH DEPARTMENT

(SEPTIC TANK) IMPROVEMENTS PERMIT AND CERTIFICATE OF COMPLETION
(Ground Absorption Sewage Disposal System -- G. S. Chapter 130-Article 13C)

OWNER OR CONTRACTOR J. L. HOPE DATE 11-17-88 PERMIT NO. 148

PHONE: Business _____ Home _____

LOCATION Hwy 64-70W-T.R. on 2nd Per Bear Loop - T.L. on 1st st - 2nd house on left.

S. R. No. _____

SUBDIVISION NAME LAKEWOOD ESTATES. LOT NO. 13 SECTION OR BLOCK NO. _____

House (✓) Mobile Home ( ) Business ( ) Other _____

No. Bedrooms 3 No. Bathrooms 1.5

Garbage Disposal Unit	Yes ( )	No (✓)	
Auto. Dishwasher	Yes ( )	No (✓)	
Auto. Wash. Machine	Yes (✓)	No ( )	
Site Suitable	Yes (✓)	No ( )	

Lot Area 101' X 150'

Character & Porosity of Soil Boy Suitable


Percolation Rate 30 min/in. ft.

Topography 2-6%

Depth to Water Table 10'+

Rock or other impervious formations none observed.

_____ Basement with Plumbing _____ Basement without Plumbing ✓ No Basement

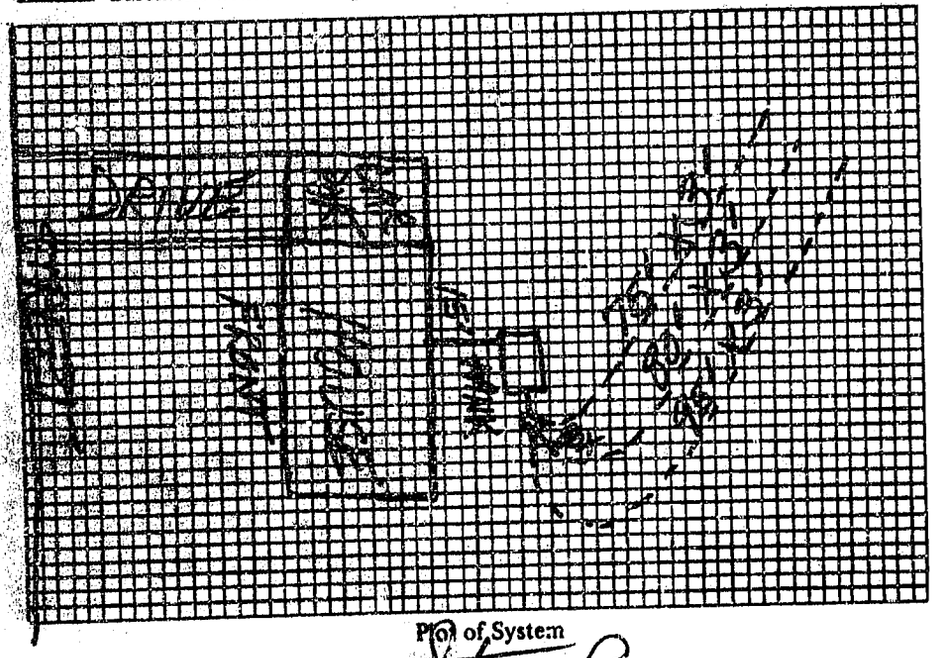

Plan of System

Size of Tank 1000 Gals.

Nitrification Field: 3

No. of Lines

Sq. Ft. 120+ Linear Ft. 240+

Depth of Stone in Lines 12"

Water Supply: Individual ( )
Public (✓)

Argie Duncan

Installed by Hope Bros.

I understand and agree to install septic tank system as specified on this Improvements Permit.

Signed: _____

IMPROVEMENTS PERMIT BY Steve Brown

COMMENTS: _____

CERTIFICATE OF COMPLETION BY Steve Brown DATE 11-17-88

EXISTING SYSTEM CHECKED BY: _____ DATE _____

CONSTRUCTION MUST COMPLY WITH ALL OTHER APPLICABLE STATE AND LOCAL REGULATIONS.

Permit is VOID if any unauthorized changes are made in installation of system and/or if any false information is supplied in making Improvements Permit.

Health Dept. Copy: White Inspection Dept. Copy: Yellow Sanitarian's Copy: Pink Owner's Copy: Gold