9:30

57376

IREDELL COUNTY HEALTH DEPARTMENT

STATESVILLE 704-878-5305 MOORESVILLE 704-664-5281

IMPROVEMENT PERMIT / CERTIFICATE OF COMPLETION / OPERATION PERMIT / EXISTING SYSTEM INSPECTION

PROPERTY DESCRIPTION NO. 21408 DATE 7-14-95 TAX MAP NO. 6E-17-A-28 Watershed: ☐ Yes ☐ No

OWNER OR CONTRACTOR Hope Brothers PHONE: Business 872-4111 Home

ADDRESS 1120 Barkley Rd. Statesville N.C. 28677

LOCATION I40W Tl Stamey Farm Rd TL Hwy 70 TR Airport Rd TR Parker Lake Loop TL Delight Loop TR Tower Dr. 4th Lot on R

SUBDIVISION Lakewood BLOCK / SECTION — LOT 28 LOT AREA ~.5 acre SITE CLASS. P.S. DESIGN FLOW 360 L.T.A.R. .25 gpd/ft²

Septic Tank: 1000 Gallons; STB 1 of 2 Date 10-21-95

Pump Tank: — Gallons; PT — Date —

Pump Make: — Model — Serial No. —

Nitrification Field: No Fields 1 Square Feet equivalent to 1440 Linear Feet 360'

No Lines 6 Trench Width 36" Max Trench Bottom Depth 36" Gravel Depth NA

☑ New System ☐ Repair System Type: I, II, III, IV, V, VI

System Description: Chambered graveless system

Repair System Description: pump to PPBPS

Maintenance Agreement Required: ☐ Yes ☑ No

☐ Slab ☑ Crawl Space ☐ Basement w/plumbing ☐ Basement wo/plumbing

☑ House/Mod. Home No. Bedrooms 3

☐ Mobile Home No. Bathrooms 2

☐ Business No. Employees —


☐ Other —

Water Supply: ☐ Individual ☐ Community ☑ Public

Comments: Install Chambered graveless systems (60 chambers total) Keep lines and trenches on center keep system min. 5' from foundation of home 10' from all property lines, and 10' from water line. 100% Repair Area above home, pump to panels. Install solid pipe from line to line by running into high holes in ends of chambers.

Comments:

INITIAL SITE SKETCH

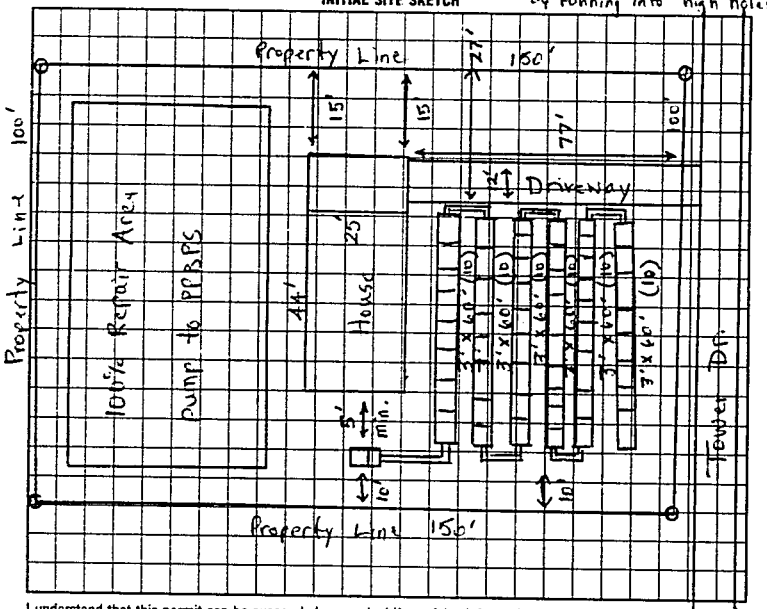

AS BUILT SKETCH

Same as initial sketch

I understand that this permit can be suspended or revoked if any false information is supplied toward securing the permit/any unauthorized changes are made to the site/any unauthorized changes are made in the installation of the system. Improvement Permit is valid for 60 months from date of issuance.

Signed: [signature]

Improvement Permit by: Richard Dennis E.C. Moore date 7-14-95

Existing System Inspection by: — date —

Installed by: Arnie Duncan (Hope Bros)

Certificate of Completion by: — date —

Operation Permit by: E.C. Moore date 4-8-96

HEALTH DEPT. COPY: WHITE INSPECTION COPY (FINAL): GREEN OWNER COPY (FINAL): YELLOW INSPECTION COPY (INITIAL): PINK OWNER COPY (INITIAL): GOLD