IREDELL COUNTY HEALTH DEPARTMENT

STATESVILLE 704-878-5305 MOORESVILLE 704-664-5281

IMPROVEMENT PERMIT / CERTIFICATE OF COMPLETION / OPERATION PERMIT / EXISTING SYSTEM INSPECTION

PROPERTY DESCRIPTION NO. 24289 DATE 7-19-96 TAX MAP NO. 6E-17-A-27 Watershed: ☐ Yes ☐ No

OWNER OR CONTRACTOR Hope Bros. PHONE: Business 872 4111 Home

ADDRESS 1120 Barkley Rd Statesville

LOCATION 70 W TL Airport Rd Turn Parker Dr TL Tower Drive 5th lot left

SUBDIVISION Lakewood Est BLOCK / SECTION LOT 27 LOT AREA 23910 SITE CLASS PS DESIGN FLOW 360 L.T.A.R. .125

Septic Tank: 1000 Gallons; STB 1017 Date 6-10-96
Pump Tank: 1000 Gallons; PT 117 Date 11-7-95
Pump Make: Liberty Model LE 61 Serial No. 8255
Nitrification Field: No Fields 1 Square Feet 1050 Linear Feet 360
No Lines 5 Trench Width 36" Max Trench Bottom Depth 36" Gravel Depth 12"

☑ New System ☐ Repair System Type: I, II, III, IV, V, VI
System Description: Pump to chambers
Repair System Description: Pump to panels
Maintenance Agreement Required: ☐ Yes ☑ No

☐ House/Mod. Home No. Bedrooms
☐ Mobile Home No. Bathrooms
☐ Business No. Employees
☐ Other


☐ Slab ☑ Crawl Space ☐ Basement w/plumbing ☐ Basement wo/plumbing

Water Supply:
☐ Individual
☐ Community
☐ Public


Comments:
See Attached Sheets For Pump Tank + Pressure manifold Set up 304'

Comments:
This Permit Replace Permit issued 7-14-95 area was Added To lot

INITIAL SITE SKETCH

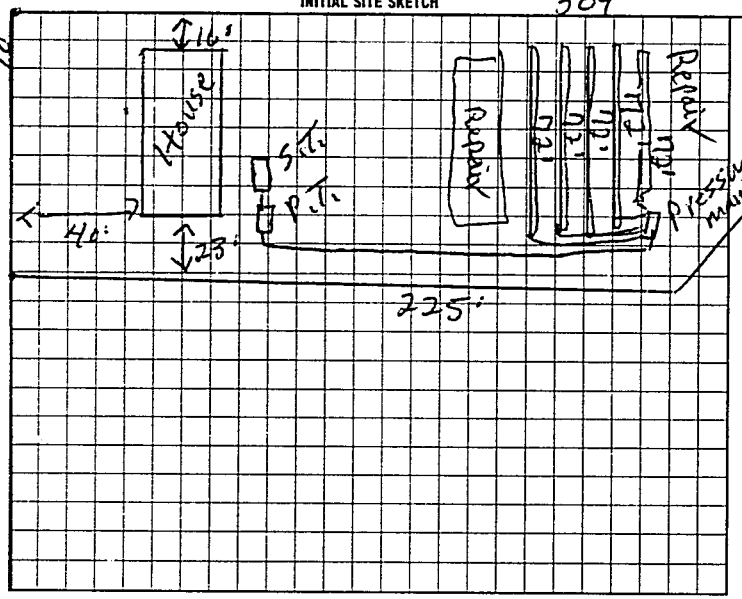

AS BUILT SKETCH

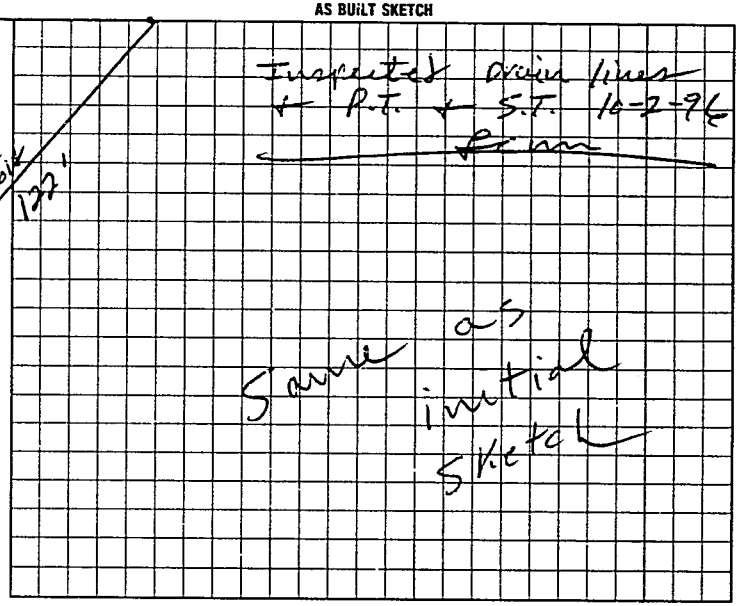

I understand that this permit can be suspended or revoked if any false information is supplied toward securing the permit/any unauthorized changes are made to the site/any unauthorized changes are made in the installation of the system.

Signed: Arnie Duncan

Improvement Permit by: E.C. moore date 7-19-96

Or Authorization to cont Existing System Inspection by: E.C. moore date 9-19-96

Installed by: Arnie Duncan

Certificate of Completion by: _____ date _____

Operation Permit by: E.C. moore date 11-26-96

HEALTH DEPT. COPY: WHITE INSPECTION COPY (FINAL): GREEN OWNER COPY (FINAL): YELLOW INSPECTION COPY (INITIAL): PINK OWNER COPY (INITIAL): GOLD

Authorization to Const Expires 6 months From Issue

IE8000