62299

IREDELL COUNTY HEALTH DEPARTMENT

STATESVILLE 704-878-5305 MOORESVILLE 704-664-5281

IMPROVEMENT PERMIT / CERTIFICATE OF COMPLETION / OPERATION PERMIT / EXISTING SYSTEM INSPECTION

PROPERTY DESCRIPTION NO. ~~24225~~ 63399 DATE 7-17-96 TAX MAP NO. 6E-17-A-12 Watershed: ☐ Yes ☐ No

OWNER OR CONTRACTOR Gene Pickens PHONE: Business Home 878 9837

ADDRESS

LOCATION Airport Rd TR Parker Loop TL Delight Loop 3rd lot Left

SUBDIVISION Lakewood BLOCK / SECTION LOT 12 LOT AREA 101' X 150' SITE CLASS. PS DESIGN FLOW 240 L.T.A.R. .28

Septic Tank: 1000 Gallons; STB 1012 Date 3-2-97
Pump Tank: Gallons; PT Date
Pump Make: Model Serial No.
Nitrification Field: No Fields 1 Square Feet 900 Linear Feet 300
No Lines 5 Trench Width 36" Max Trench Bottom Depth 36" Gravel Depth 12"

☑ New System ☐ Repair System Type: I, II, III, IV, V, VI
System Description: Conv. Gravity
Repair System Description: Gravity Chambers
Maintenance Agreement Required: ☐ Yes ☐ No

☑ House/Mod. Home No. Bedrooms 2
☐ Mobile Home No. Bathrooms 2
☐ Business No. Employees
☐ Other


☐ Slab ☑ Crawl Space ☐ Basement w/plumbing ☐ Basement wo/plumbing

Water Supply: ☐ Individual ☐ Community ☑ Public


Comments:

Comments:

INITIAL SITE SKETCH

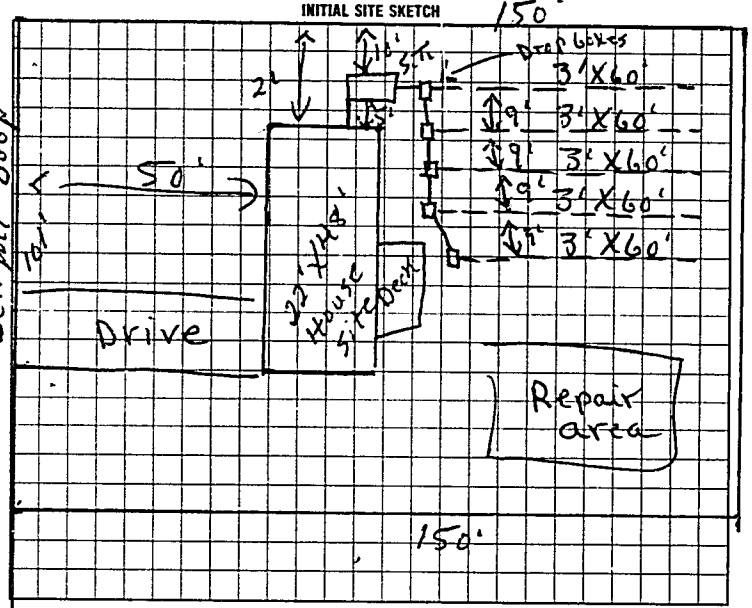

AS BUILT SKETCH

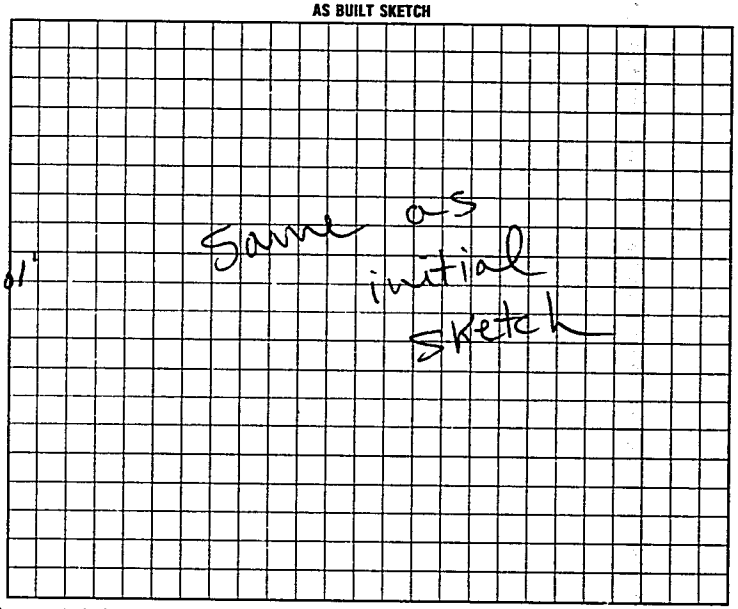

I understand that this permit can be suspended or revoked if any false information is supplied toward securing the permit/any unauthorized changes are made to the site/any unauthorized changes are made in the installation of the system.

Signed: X Gene Pickens

Improvement Permit by: R. C. Moore date 7-17-96

authorization to cover Dept. COPY: WHITE

R. C. Moore date 7-17-96

INSPECTION COPY (FINAL): GREEN

Authorization to count

Installed by: A-1 Backhoe

Certificate of Completion by: date

OWNER COPY (FINAL): YELLOW

Operation Permit by: R. C. Moore date 5-7-97

INSPECTION COPY (INITIAL): PINK

EXPIRES 60 MOS FROM ISSUE

OWNER COPY (INITIAL): GOLD