47685

IREDELL COUNTY HEALTH DEPARTMENT

STATESVILLE 704-878-5305 MOORESVILLE 704-664-5281

IMPROVEMENT PERMIT / CERTIFICATE OF COMPLETION / OPERATION PERMIT / EXISTING SYSTEM INSPECTION

PROPERTY DESCRIPTION NO. 16525 DATE 6-21-93 TAX MAP NO. 6E-17-A-1

OWNER OR CONTRACTOR Edwin Hunter Homes PHONE: Business 873-1148 Home

ADDRESS

LOCATION I40W TL Stamey Farm Rd TL Hwy 70 TR Airport Rd. Lot on R in corner of Airport Rd and Parker Loop Rd.

SUBDIVISION Lakewood Estates BLOCK / SECTION LOT 1 LOT AREA 150'x190' SITE CLASS. P.S. L.T.A.R. .35 gpd/ft²

Water Supply: ☐ Individual ☐ Community ☑ Public County Water

Septic Tank: 1000 Gallons: STB 358 Date 9-13-13

Pump Tank: — Gallons: PT — Date —

Nitrification Field: No Fields 1 Square Feet 1035 Linear Feet 345'

No Lines 3 Trench Width 36" Trench Depth 36" Gravel Depth 12"

☑ New System ☐ Repair System Type: I. (II.) II. IV. V. VI

System Description: Conventional, gravity

Repair System Description:

Maintenance Agreement Required: ☐ Yes ☑ No

☑ House/Mod. Home ☐ Mobile Home ☐ Business ☐ Other

No. Bedrooms 3 No. Bathrooms 1.5 No. Employees —

Garbage Disposal: ☐ Yes ☑ No

Auto. Dishwasher: ☐ Yes ☑ No


Auto. Washing Machine: ☑ Yes ☐ No

Other


☐ Slab ☑ Crawl Space ☐ Basement w/plumbing ☐ Basement wo/plumbing

Comments Keep Nitrification Lines on contour. Keep system 5' from foundation of home, 10' from all property lines, and 10' from water line. 100% Repair Area in front of home, conventional, gravity fed.

INITIAL SITE SKETCH

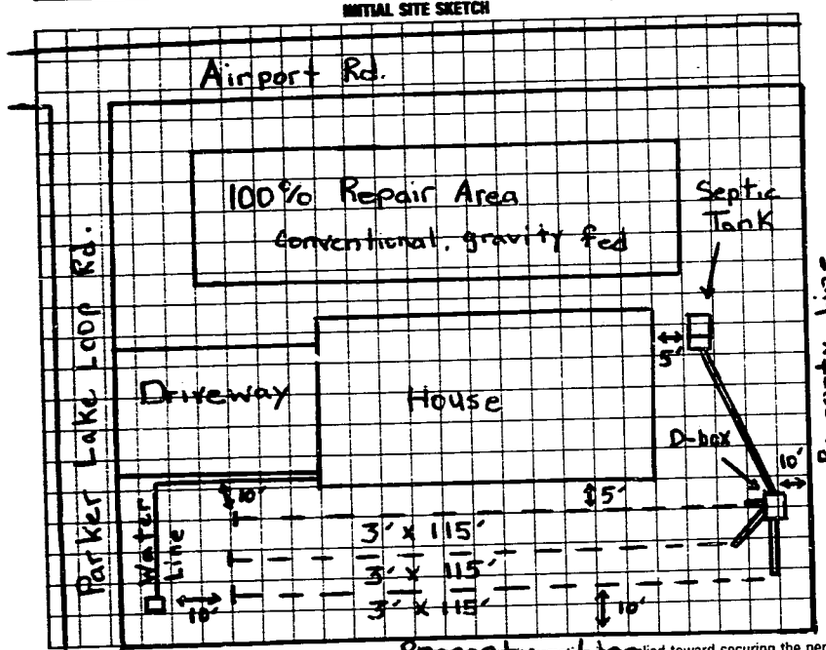

AS BUILT SKETCH

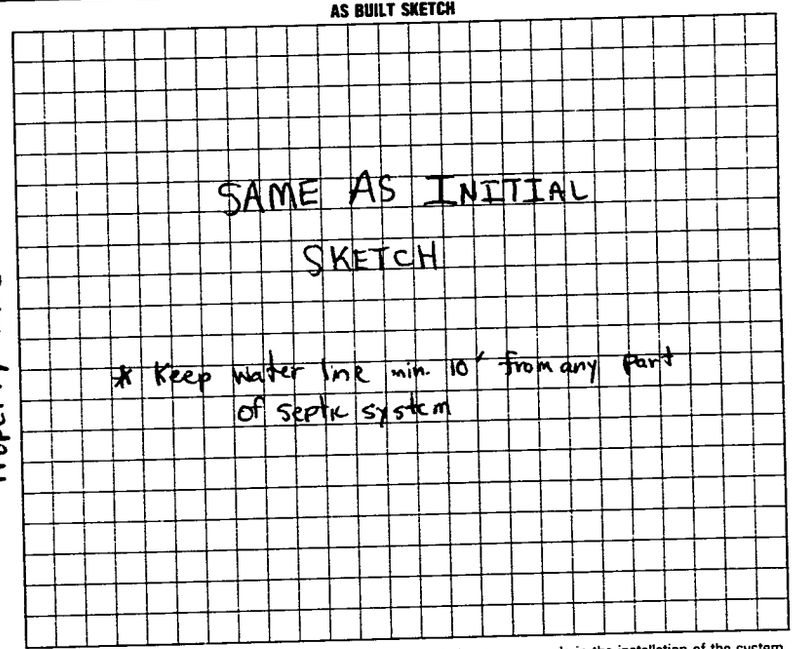

I understand that this permit can be suspended or revoked if false information is supplied toward securing the permit/any unauthorized changes are made to the site/any unauthorized changes are made in the installation of the system. Improvement Permit is valid for 60 months from date of issuance.

Signed: John T. Edwards Jr.

Improvement Permit by: Michael J. Dennis date 6-21-93

Existing System Inspection by: date

Installed by: Yount and Sons Grading

Certificate of Completion by: Michael J. Dennis date 10-20-93

Operation Permit by: date

HEALTH DEPT. COPY: WHITE INSPECTION COPY (FINAL): GREEN OWNER COPY (FINAL): YELLOW INSPECTION COPY (INITIAL): PINK OWNER COPY (INITIAL): GOLD