...ELL COUNTY HEALTH DEPARTMENT
...ROVEMENT PERMIT / AUTHORIZATION TO CONSTRUCT / OPERATION PERMIT / EXISTING SYSTEM INSPECTION

STATESVILLE 704-878-5305 MOORESVILLE 704-664-5281

13908 7

R APPLICANT Moorefield Builders PIN# 4723602005

1816 Old Mocksville Hwy Statesville NC 28625 PHONE: Business 880-6620 Home 880-6603 DATE 3-4-08

IN Buffalo Creek BLOCK / SECTION Buffalo Creek Sub LOT 8 LOT AREA 2.88 SITE CLASS PS DESIGN FLOW 480 L.T.A.R. .3

k: 1200 Gallons: STB Date

Gallons: PT 1017 Date 11-5-07

Model Serial No.

Field: No. Fields 1 Square Feet 480 (160) Linear Feet 400'

2133' Trench Width 36 Trench Bottom Depth 22" TS Gravel Depth N/A

☒ New System ☐ Repair ☐ Expansion System Type: I II III IV V

System Description: Conv 3 Solo Recpt

Repair System Description: Same

Maintenance Agreement Required: ☐ Yes ☑ No

☒ Gravity ☐ Pressure ☐ Slab ☐ Crawl Space ☒ Basement w/plumbing ☐ Basement w/o plumbing

☒ House/Mod. Home ☐ Mobile Home ☐ Business ☐ Other

No. Bedrooms 4 No. Persons 8 No. Employees

Water Supply: ☐ Individual ☐ Public ☐ Community

Conditions: ① NOTE MAXIMUM TRENCH BOTTOM OF 22" ② BUILDER STATED HE WOULD KEEP TO 1st LINE FROM BASEMENT CUT. HE WOULD MEET & DISCUSS FILL / GRADE / TANK, ETC...

Comments/Conditions: ③ TO MAKE SURE THIS COULD BE MAINTAINED. ④ SYSTEM ELABORATED COMPLETELY AS WELL AS THE MOST.

INITIAL SITE SKETCH

SEE ATTACHED SYSTEM LESTED BY LORNE COCK, P.S.

AS BUILT SKETCH

TUFFATE FILL MATERIAL

WELL 75 10' From TANK 1½" PVC PRE FOOT ON Supply Ind to 1ST DROP BOX

Location of the proposed 24'x30' Garage addition does not appear to impact the existing on-site septic system or well.**NOTE:

REHS Date: 4-15-14

ICHD-Environmental Health Division

Charles Ramsey
Permit # 202674

...r revoked if any false information is supplied toward securing the permit/any unauthorized changes are made to the site/any unauthorized changes are made in the installation of the system. Improvement ...ut expiration. ☐ Improvement Permit with site plan valid for sixty months. Authorization to Construct is valid for a period equal to that of Improvement Permit – not to exceed sixty months.

date 3/5/08

Installed by: Piedmont

date 3-4-08


Operation Permit by:

date 3-5-08

Existing System Inspection by:

date 8-5-08

HEALTH DEPT. COPY: WHITE OWNER COPY (FINAL): YELLOW OWNER COPY (INITIAL): PINK

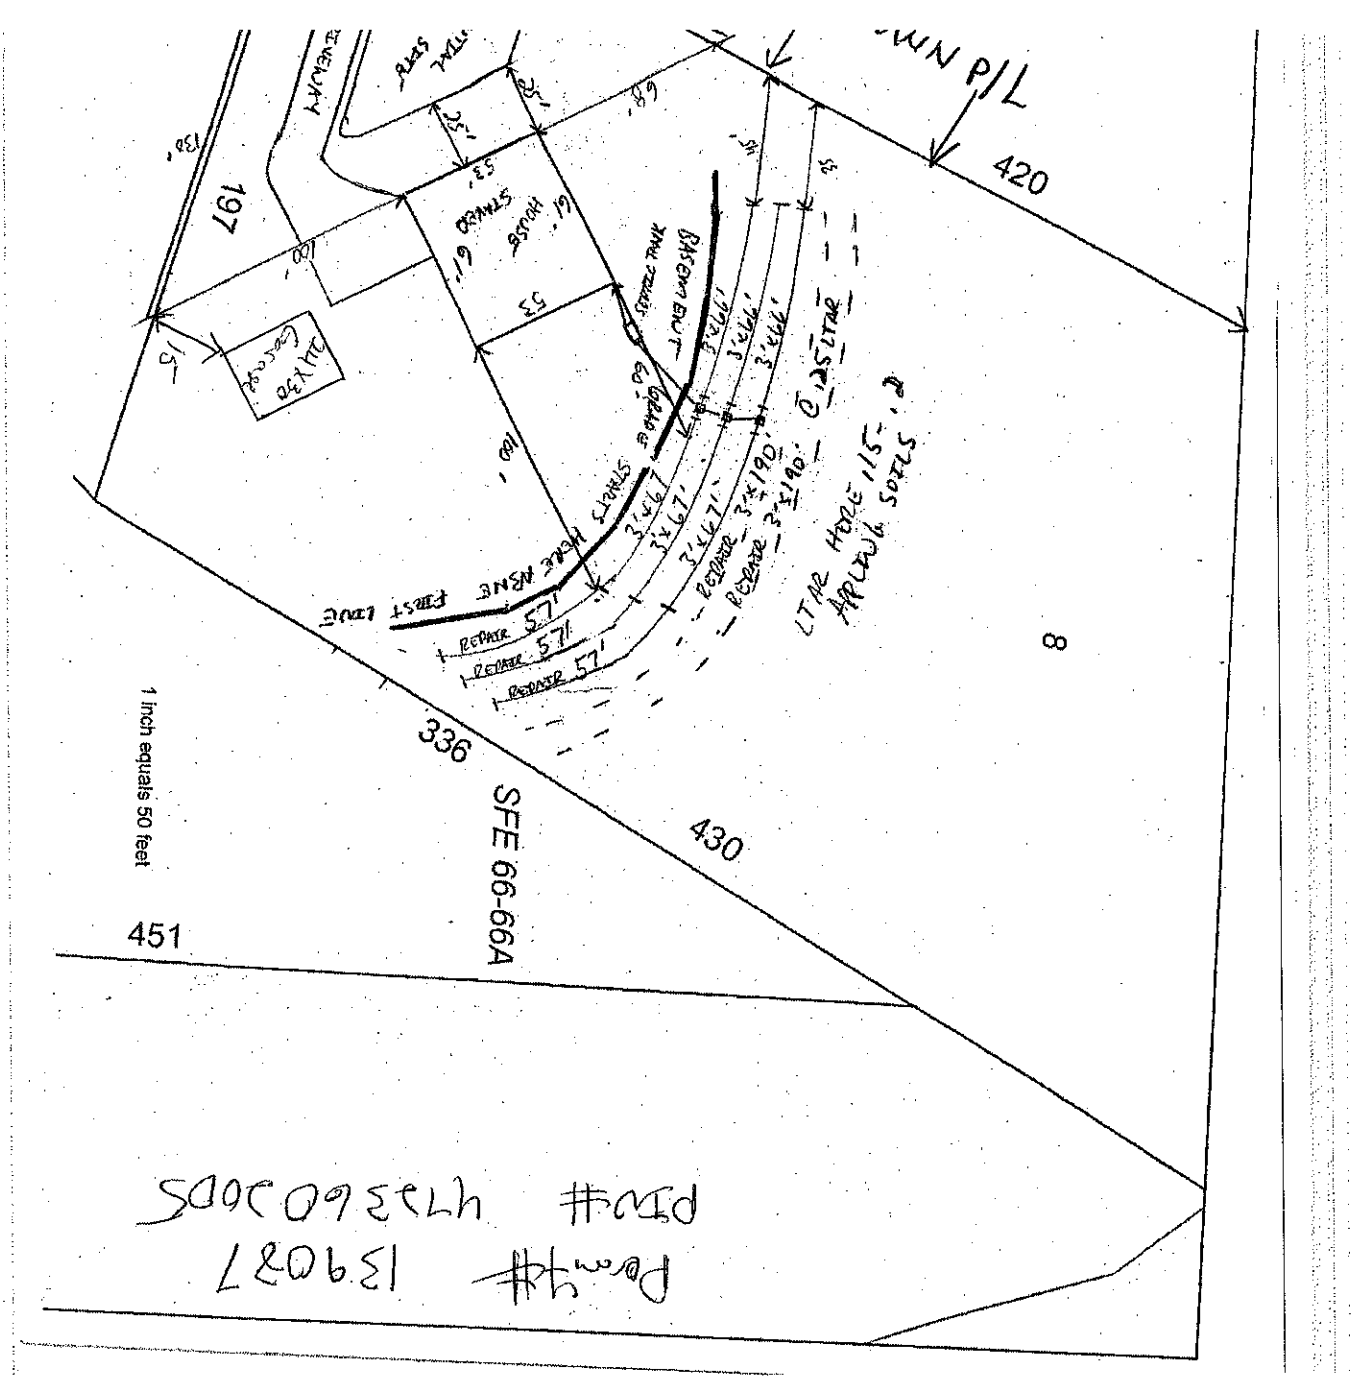

Permit # 13902J7

PID# 472360305