IREDELL COUNTY HEALTH DEPARTMENT

STATESVILLE 704-878-5305 MOORESVILLE 704-664-5281

52722

IMPROVEMENT PERMIT / CERTIFICATE OF COMPLETION / OPERATION PERMIT / EXISTING SYSTEM INSPECTION

PROPERTY DESCRIPTION NO. 18287 DATE 4-18-94 TAX MAP NO. 6C-7-A-3 Watershed: ☐ Yes ☑ No

OWNER OR CONTRACTOR Sidney Alford PHONE: Business Home 663-0230

ADDRESS Rt. 4 Box 898 Mooresville N.C. 28115

LOCATION I40W TL Old Mtn. Rd. TL Buffalo Shoals Rd TL Grandview Dr. lot on corner of Grandview and Brandywine.

SUBDIVISION Glen Ridge 3/0 BLOCK / SECTION LOT 3 LOT AREA 1.2 acres SITE CLASS P.S. DESIGN FLOW 360 L.T.A.R. .3 gpd / ft²

Septic Tank: 1000 Gallons; STB 794 Date 11/4/94
Pump Tank: — Gallons; PT — Date —
Pump Make: — Model — Serial No. —
Nitrification Field: No Fields 1 Square Feet 1200 Linear Feet 400'
No Lines 4 Trench Width 36" Max Trench Bottom Depth 24" Gravel Depth 12"

☑ New System ☐ Repair System Type: I, (II), III, IV, V, VI
System Description: conventional, gravity fed
Repair System Description: " "
Maintenance Agreement Required: ☐ Yes ☑ No


☑ House/Mod. Home No. Bedrooms 3
☐ Mobile Home No. Bathrooms 2
☐ Business No. Employees
☐ Other
☐ Slab ☑ Crawl Space ☐ Basement w/plumbing ☐ Basement wo/plumbing

Water Supply: ☑ Individual ☐ Community ☐ Public

Comments: INSTALL SYSTEM SHALLOW (no deeper than 24" to trench bottom) Keep Nitrification Lines and Trenches on contour. Keep system 5' from foundation of home, 10' from all property lines and 50' from any well. 100% Repair below system, conventional, gravity fed.

Comments:

INITIAL SITE SKETCH

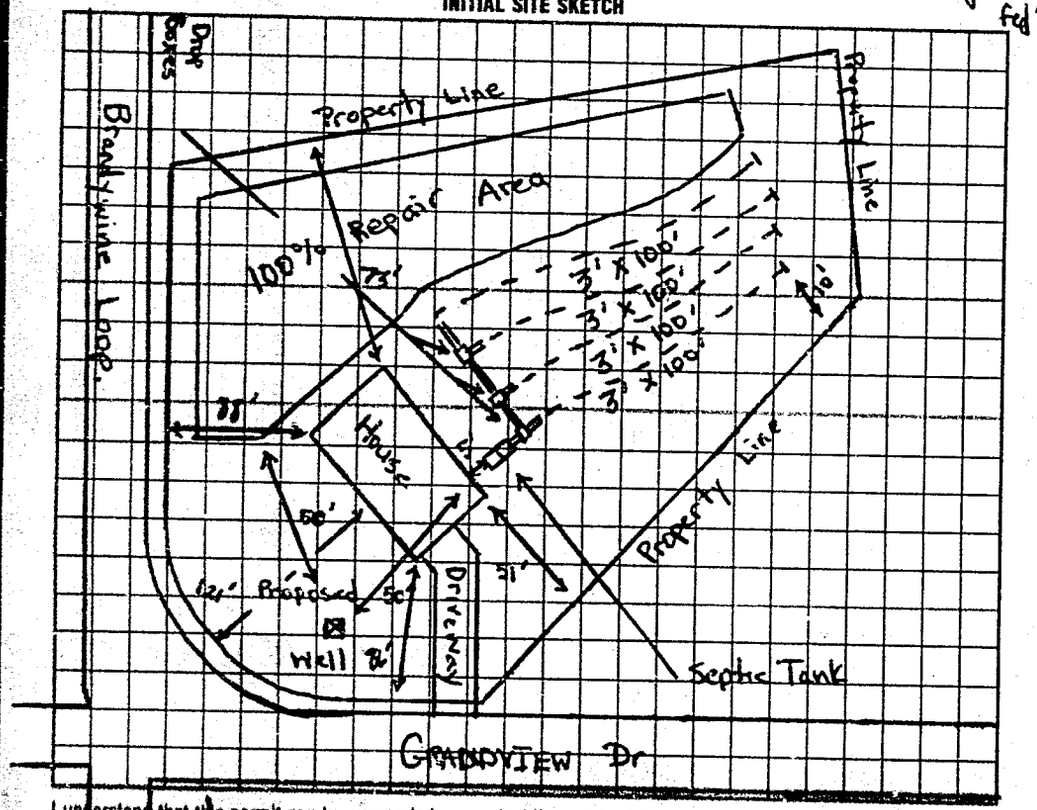

AS BUILT SKETCH

SYSTEM INSTALLED ACCORDING TO INITAL SITE SKETCH

I understand that this permit can be suspended or revoked if any false information is supplied toward securing the permit/any unauthorized changes are made to the site/any unauthorized changes are made in the installation of the system. Improvement Permit is valid for 60 months from date of issuance.

Signed: Sidney F. Alford

Improvement Permit by: Michael D. Dennis date 4-18-94

Existing System Inspection by: date

Installed by: JAMES HUDLER

Certificate of Completion by: STEVE HENDRICK date 12/21/94

Operation Permit by: date

HEALTH DEPT COPY: WHITE INSPECTION COPY (FINAL): GREEN OWNER COPY (FINAL): YELLOW INSPECTION COPY (INITIAL): PINK OWNER COPY (INITIAL): GOLD