IREDELL COUNTY HEALTH DEPARTMENT

STATESVILLE 704-878-5305 — MOORESVILLE 704-664-5281

Charlie Brice 4:00pm+

IMPROVEMENT PERMIT / CERTIFICATE OF COMPLETION / OPERATION PERMIT / EXISTING SYSTEM INSPECTION

PROPERTY DESCRIPTION NO. ~~20207~~ 20202 DATE 12-6-95 TAX MAP NO. 6C-7-A-5 Watershed: ☐ Yes ☐ No

OWNER OR CONTRACTOR Chris Davidson PHONE: Business 528-6192 Home

ADDRESS PO Box 5602 Buffalo Shoals STA

LOCATION TR Grandview TR Brandywine On Rt

SUBDIVISION Glen Ridge BLOCK / SECTION LOT 5 LOT AREA 1.39acres SITE CLASS. PS DESIGN FLOW 360 L.T.A.R. 1.3

Septic Tank: 1000 Gallons; STB 55 Date 11-3-98
Pump Tank: Gallons; PT Date
Pump Make: Model Serial No.
Nitrification Field: No Fields 1 Square Feet 1200 Linear Feet 400
No Lines 3 Trench Width 36" Max Trench Bottom Depth 18to24 Gravel Depth

☑ New System ☐ Repair System Type: I, II, III, IV, V, VI
System Description: Shallow Conv. Gravity
Repair System Description: LPP
Maintenance Agreement Required: ☐ Yes ☑ No

☑ House/Mod. Home No. Bedrooms 3
☐ Mobile Home No. Bathrooms 2
☐ Business No. Employees
☐ Other


☐ Slab ☑ Crawl Space ☐ Basement w/plumbing ☐ Basement wo/plumbing

Water Supply: ☑ Individual ☐ Community ☐ Public


Comments:
maximum depth 24" Run on contour of slope
Keep well max. feasible distance over 50'

Comments: ① SYSTEM CHANGED AS SHOWN BELOW WITHOUT PRIOR AUTHORIZATION FROM HEALTH DEPARTMENT ② WELL IS NOT MAXIMUM FEASIBLE DISTANCE FROM SYSTEM.

INITIAL SITE SKETCH

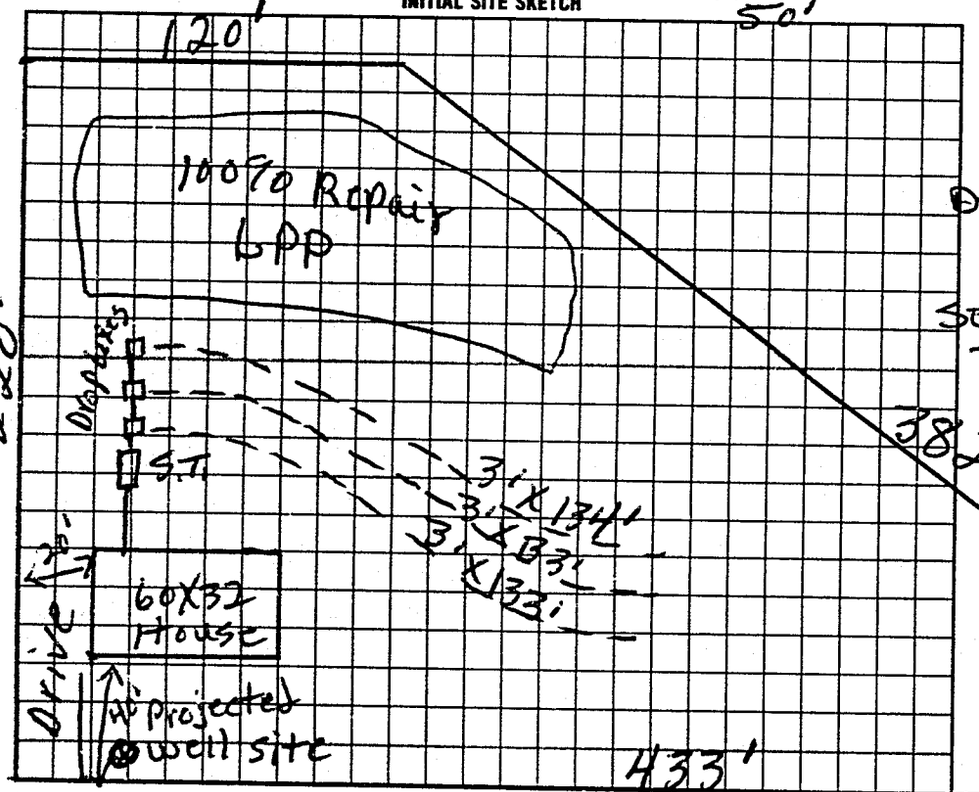

AS BUILT SKETCH

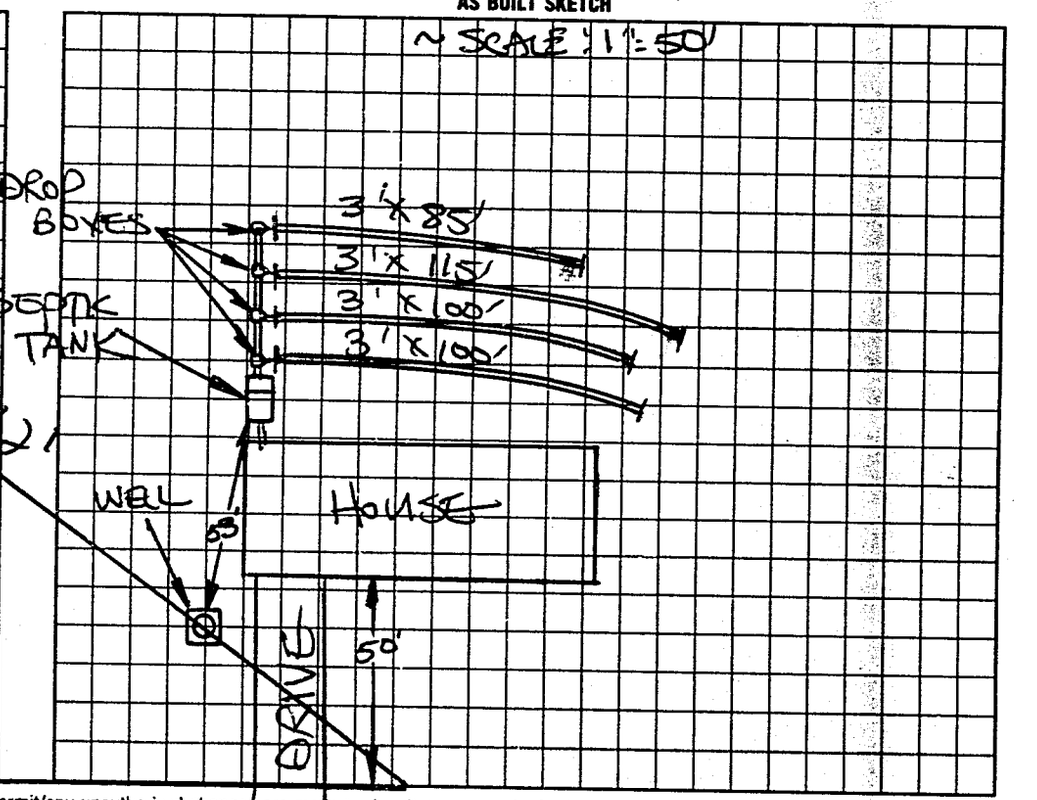

I understand that this permit can be suspended or revoked if any false information is supplied toward securing the permit/any unauthorized changes are made to the site/any unauthorized changes are made in the installation of the system.

Signed:

Improvement Permit by: L.C. Moore date 12-6-95

Existing System Inspection/Authorization to Const. L.C. Moore date 12-6-95

Installed by: CHARLIE BRICE

~~Certificate of Completion by: STEVE HEARICK date 12-21-98~~

Operation Permit by: STEVE HEARICK date 12-21-98

HEALTH DEPT. COPY: WHITE — INSPECTION COPY (FINAL): GREEN — OWNER COPY (FINAL): YELLOW — INSPECTION COPY (INITIAL): PINK — OWNER COPY (INITIAL): GOLD

Authorization to Const. Expires 60 mos from date of issue