IREDELL COUNTY HEALTH DEPARTMENT

STATESVILLE 704-878-5305 MOORESVILLE 704-664-5281

IMPROVEMENT PERMIT / CERTIFICATE OF COMPLETION / OPERATION PERMIT / EXISTING SYSTEM INSPECTION

PROPERTY DESCRIPTION NO. 1863 & 2607 DATE 12-6-95 TAX MAP NO. 6C-7-A-6 Watershed: ☐ Yes ☐ No

OWNER OR CONTRACTOR Chris Davidson PHONE: Business 528-6192 Home

ADDRESS PO Box 5602 Statesville

LOCATION Buffalo Shoals TR Grandview TR Brandywine Up on Rt

SUBDIVISION Glenn Ridge BLOCK / SECTION LOT 6 LOT AREA 1.68 acres SITE CLASS 3 DESIGN FLOW 360 L.T.A.R. .13

Septic Tank: 1000 Gallons; STB 1012 Date 7/19/99

Pump Tank: Gallons; PT Date

Pump Make: Model Serial No.

Nitrification Field: No Fields 1 Square Feet 1200 Linear Feet 400

No Lines 3 Trench Width 36" Max Trench Bottom Depth 18 to 24" Gravel Depth 12"

☑ New System ☐ Repair System Type: I, II, III, IV, V, VI

System Description: Shallow Conv.

Repair System Description: LPP

Maintenance Agreement Required: ☐ Yes ☑ No

☑ House/Mod. Home ☐ Mobile Home ☐ Business ☐ Other

No. Bedrooms 3 No. Bathrooms 2 No. Employees

☐ Slab ☑ Crawl Space ☐ Basement w/plumbing ☐ Basement wo/plumbing


Water Supply: ☑ Individual ☐ Community ☐ Public

Comments:


Drain lines must be installed Shallow No more than 24" deep

Comments:

INITIAL SITE SKETCH

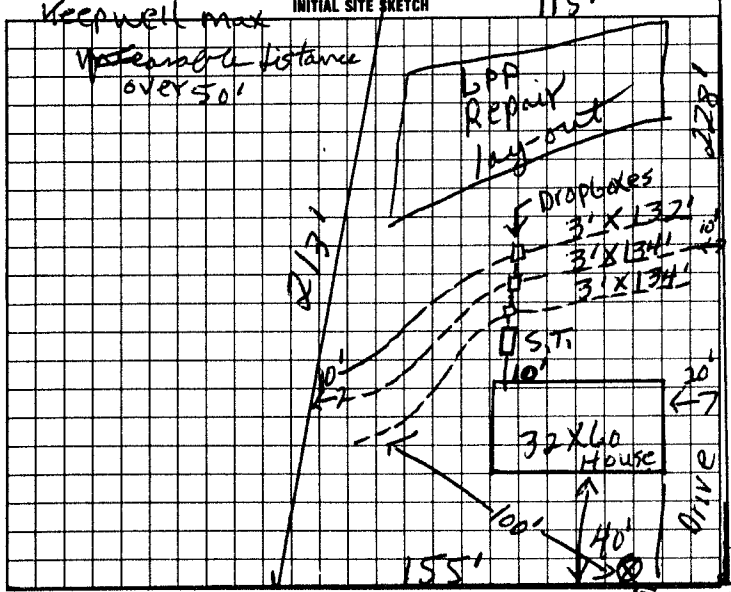

AS BUILT SKETCH

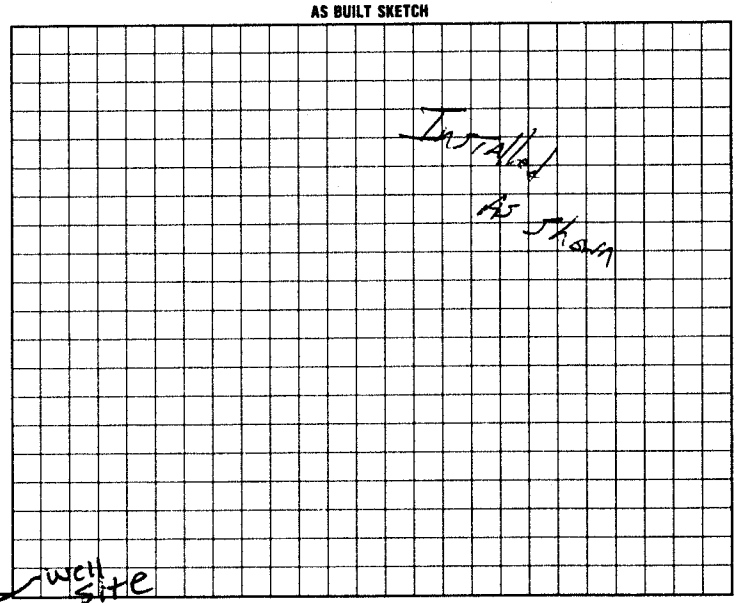

I understand that this permit can be suspended or revoked if any false information is supplied toward securing the permit/any unauthorized changes are made to the site/any unauthorized changes are made in the installation of the system.

Signed: C A Davidson

Improvement Permit by: L.C. Moore date 12-6-95

Existing System Inspection by: L.C. Moore date 12-6-95

Installed by: Young & Sons & Potter

Certificate of Completion by: date Nov 1999

Operation Permit by: date

TO COUNTY HEALTH DEPT. COPY: WHITE INSPECTION COPY (FINAL) GREEN OWNER COPY (FINAL) YELLOW INSPECTION COPY (INITIAL) PINK OWNER COPY (INITIAL) GOLD

Authorization to Const. Expires 60 mos from date of issue