IREDELL COUNTY HEALTH DEPARTMENT

STATESVILLE 704-878-5305 MOORESVILLE 704-664-5281

IMPROVEMENT PERMIT / AUTHORIZATION TO CONSTRUCT / OPERATION PERMIT / EXISTING SYSTEM INSPECTION

PERMIT# 76331 PIN# 4723 62 2999 DATE 9-15-98

OWNER OR CONTRACTOR Joe M Troutman PHONE: Business Home 528 2666

ADDRESS 105 Dawnwood Lane Statesville, N.C.

LOCATION Buffalo Shoales Turn Grantview Near Ent Rt.

SUBDIVISION Glenn Ridge BLOCK / SECTION LOT 12+13 LOT AREA 2 acre+ SITE CLASS PS DESIGN FLOW 360 L.T.A.R. 1.3

Septic Tank: 1000 Gallons; STB 620 Date 7-17-94
Pump Tank: Gallons; PT Date
Pump Make: Model Serial No.
Nitrification Field: No Fields 1 Square Feet 1200 Linear Feet 400
No Lines 3 Trench Width 36" Max Trench Bottom Depth 36" Gravel Depth 12"

☒ New System ☐ Repair System Type: ☐ I ☐ II, IV, V, VI
System Description: Conv. Gravity
Repair System Description: Pump To Conv. Lines
Maintenance Agreement Required: ☐ Yes ☐ No


☒ House/Mod. Home No. Bedrooms 3
☐ Mobile Home No. Bathrooms 2 1/2
☐ Business No. Employees
☐ Other
☐ Slab ☒ Crawl Space ☐ Basement w/plumbing ☐ Basement wo/plumbing

Water Supply: ☒ Individual ☐ Public ☐ Community

Comments/Conditions:


Driveway

INITIAL SITE SKETCH

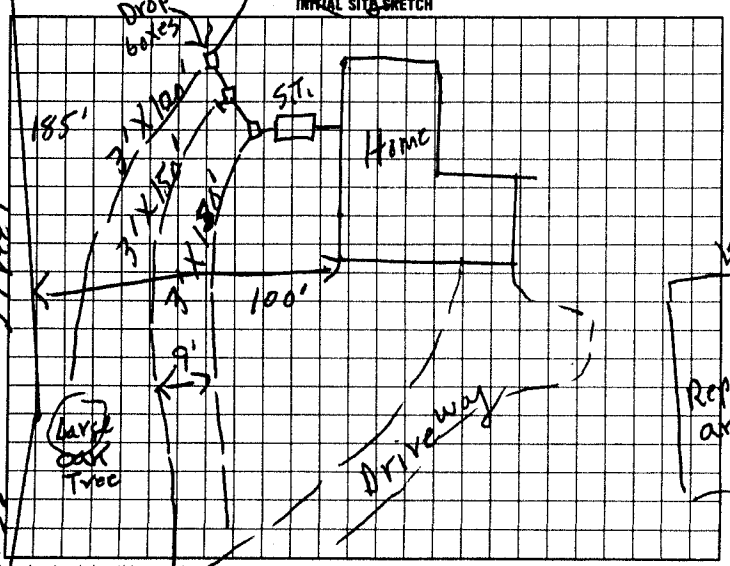

Comments/Conditions:

AS BUILT SKETCH

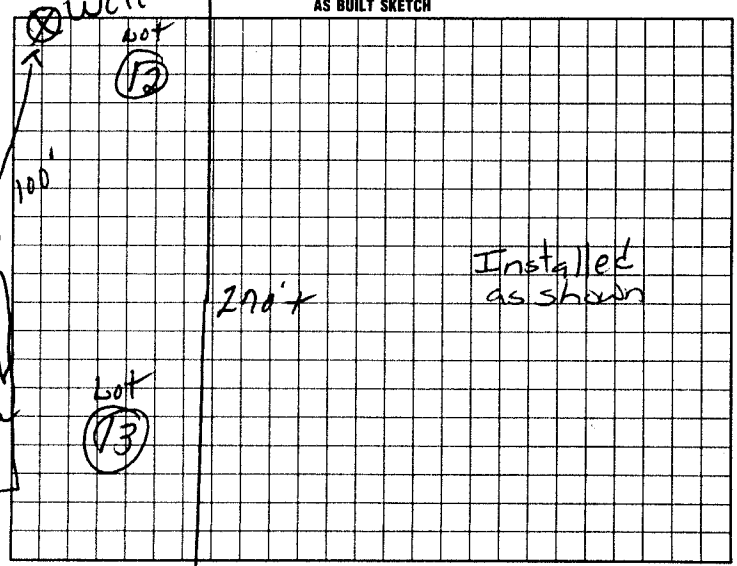

I understand that this permit can be suspended or revoked if any false information is supplied toward securing the permit/any unauthorized changes are made to the site/any unauthorized changes are made in the installation of the system. Improvement Permit with plat valid without expiration. Improvement Permit with site plan valid for sixty months. Authorization to Construct is valid for a period equal to that of Improvement Permit – not to exceed sixty months.

Signed: Joe M Troutman date

Improvement Permit by: P. C. Moore date 9-15-98

Authorization to Construct by: P. C. Moore date 9-15-98

Installed by: Kenny Madison

Operation Permit by: Mat Curtis date 6-29-99

Existing System Inspection by: date

HEALTH DEPT. COPY: WHITE INSPECTION COPY (FINAL): GREEN OWNER COPY (FINAL): YELLOW INSPECTION COPY (INITIAL): PINK OWNER COPY (INITIAL): GOLD