IREDELL COUNTY HEALTH DEPARTMENT

STATESVILLE 704-878-5305 MOORESVILLE 704-664-5281

IMPROVEMENT PERMIT / AUTHORIZATION TO CONSTRUCT / OPERATION PERMIT / EXISTING SYSTEM INSPECTION

PERMIT# 86164 PIN# 4723622070 DATE Nov 24.99

OWNER OR CONTRACTOR David Meehan PHONE: Business 528 6378 Home

ADDRESS 125 Galaxy Dr Statesville, NC

LOCATION 144 Brandywine Loop Lot 7 Glen Ridge Take Grandview off Buffalo Shoals Rd (8) Brandywine 3rd or 4th on Right

SUBDIVISION Glen Ridge BLOCK / SECTION 1 LOT 7 LOT AREA .69 SITE CLASS. DESIGN FLOW L.T.A.R. .3

Septic Tank: 1000 Gallons; STB 1007 Date 5 20-00
Pump Tank: Gallons; PT Date
Pump Make: Model Serial No.
Nitrification Field: No Fields 1 Square Feet 1200 Linear Feet 300
No Lines 4 Trench Width 36" Max Trench Bottom Depth 36" Gravel Depth

☒ New System ☐ Repair System Type: I, II, III, IV, V, VI
System Description: Gravity 25% Reduction
Repair System Description: Rep 25% Reduction
Maintenance Agreement Required: ☐ Yes ☒ No


☒ House/Mod. Home No. Bedrooms 3
☐ Mobile Home No. Bathrooms 2
☐ Business No. Employees
☐ Other
☐ Slab ☒ Crawl Space ☐ Basement w/plumbing ☐ Basement wo/plumbing

Water Supply: ☒ Individual ☐ Public ☐ Community WELL


Comments/Conditions: 50 Chambers OR 30 HDS Sections
If using Chambers join middle Lines w/solid pipe To Keep well 100ft from Septic System.
Building Foundation MUST be A min. of 5ft from Septic Lines

Comments/Conditions: Zabel Filter used
Allow for Curve
6 Lines 8 Chambers / Line
TOTAL 48 Chambers

INITIAL SITE SKETCH

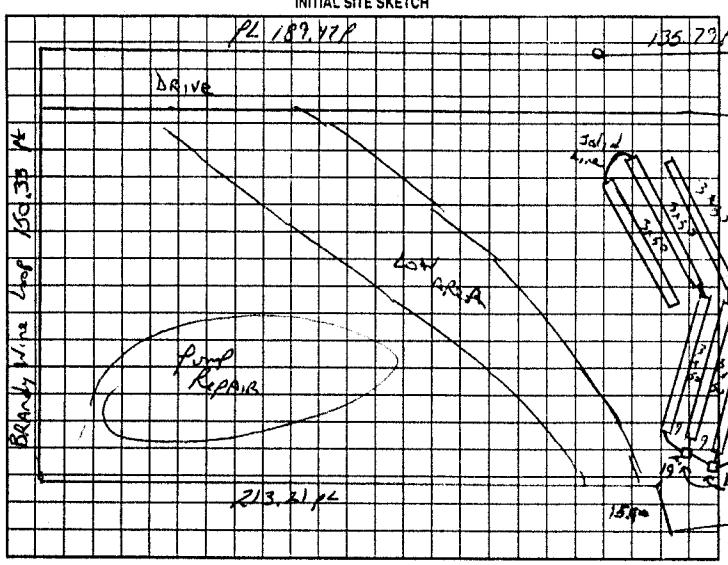

AS BUILT SKETCH

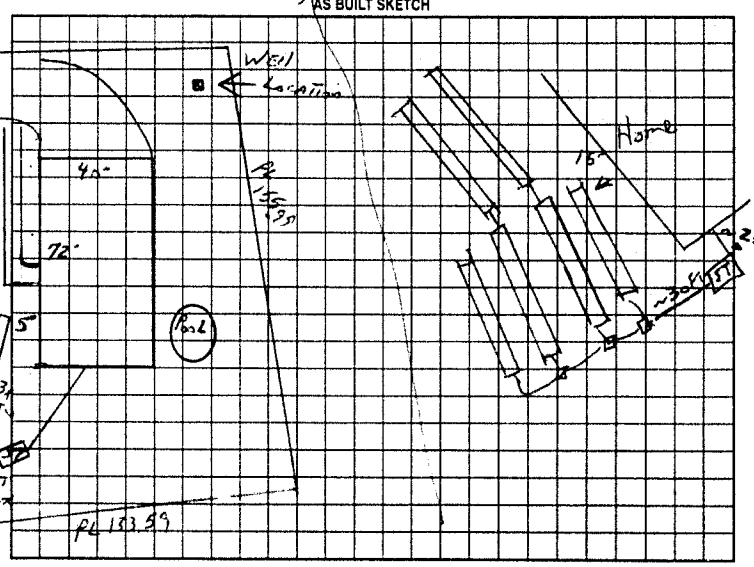

Permit can be suspended or revoked if any false information is supplied toward securing the permit/any unauthorized changes are made to the site/any unauthorized changes are made in the installation of the system. Improvement Permit with plat valid without expiration. Improvement Permit with site plan valid for sixty months. Authorization to Construct is valid for a period equal to that of Improvement Permit – not to exceed sixty months.

Signed: David Meehan date

Improvement Permit by: Jc Potter date Nov 24 99

Authorization to Construct by: Jc Potter date Nov 24 99

Installed by: J + J Backhoe

Operation Permit by: Jc Potter date June 25 2000

Existing System Inspection by: date

HEALTH DEPT. COPY: WHITE OWNER COPY (FINAL): YELLOW OWNER COPY (INITIAL): PINK