pd 175 2-18-98

IREDELL COUNTY HEALTH DEPARTMENT

STATESVILLE 704-878-5305 MOORESVILLE 704-664-5281

IMPROVEMENT PERMIT / AUTHORIZATION TO CONSTRUCT / OPERATION PERMIT / EXISTING SYSTEM INSPECTION

PERMIT# 19154 72300 PIN# 6C-7-A 17+18 DATE 2-17-98

OWNER OR CONTRACTOR Allen Freeze PHONE: Business Home 8736815

ADDRESS Po Box 5764 Statesville, N.C.

LOCATION Buffalo Shoals Turn Grantview Dr. at end

SUBDIVISION Glenn Ridge BLOCK / SECTION LOT 17+18 LOT AREA 3.5 acres SITE CLASS PS DESIGN FLOW 360 L.T.A.R. .3

Septic Tank: 1000 Gallons; STB 794 Date 4-6-98
Pump Tank: 1000 Gallons; PT Date 4-25-98
Pump Make: Hydromatic Model SHEF50M1 Serial No. 5187200
Nitrification Field: No Fields 1 Square Feet 1200 Linear Feet 400
No Lines 4 Trench Width 36" Max Trench Bottom Depth 36" Gravel Depth 12"

[X] New System [ ] Repair System Type: [ ] I [ ] II [ ] III [ ] IV [ ] V [ ] VI
System Description: Pump to conv.
Repair System Description: " " "
Maintenance Agreement Required: [ ] Yes [X] No


[X] House/Mod. Home No. Bedrooms 3
[ ] Mobile Home No. Bathrooms 3½
[ ] Business No. Employees
[ ] Other
[ ] Slab [X] Crawl Space [ ] Basement w/plumbing [ ] Basement wo/plumbing

Water Supply: [X] Individual [ ] Public [ ] Community


Comments:/Conditions:

Comments:/Conditions: Installed as shown

INITIAL SITE SKETCH

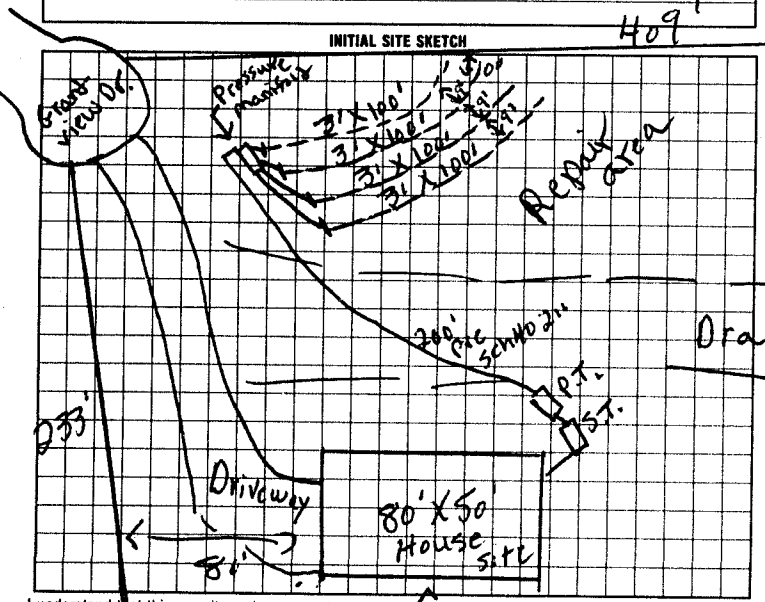

AS BUILT SKETCH

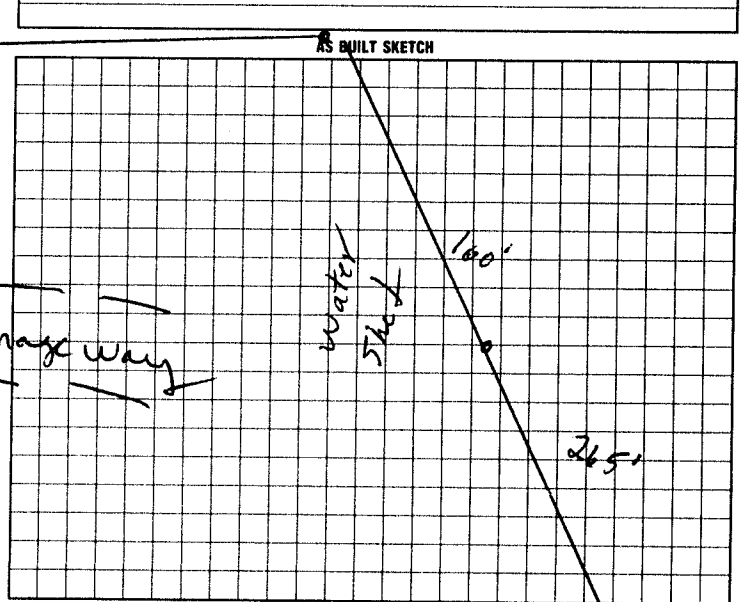

I understand that this permit can be suspended or revoked if any false information is supplied toward securing the permit/any unauthorized changes are made to the site/any unauthorized changes are made in the installation of the system. Improvement Permit with plat valid without expiration. Improvement Permit with site plan valid for sixty months. Authorization to Construct is valid for a period equal to that of Improvement Permit – not to exceed sixty months.

Signed: ⊗ well site 50' Allen Freeze date

Improvement Permit by: E. C. Moore date 2-17-98 Installed by: James Huddler

Authorization to Construct by: E. C. Moore date 2-17-98 Operation Permit by: Mary C Curtis date 6-23-99

Existing System Inspection by: 345 date

HEALTH DEPT. COPY: WHITE INSPECTION COPY (FINAL): GREEN OWNER COPY (FINAL): YELLOW INSPECTION COPY (INITIAL): PINK OWNER COPY (INITIAL): GOLD