IREDELL COUNTY HEALTH DEPARTMENT

STATESVILLE 704-878-5305 MOORESVILLE 704-664-5281

IMPROVEMENT PERMIT / CERTIFICATE OF COMPLETION / OPERATION PERMIT / EXISTING SYSTEM INSPECTION

PROPERTY DESCRIPTION NO. 24293 062862 DATE 7-11-96 TAX MAP NO. 6E-17-A-39 Watershed: ☐ Yes ☐ No

OWNER OR CONTRACTOR Hope Bros. Inc. PHONE: Business 872 4111 Home

ADDRESS 1120 Barkley Rd Statesville

LOCATION Buffalo Shoals TR Airport TL Parker Lake TL Tower 2nd lot Rt 6 Fore curve

SUBDIVISION Lakewood Est. BLOCK / SECTION II LOT 39 LOT AREA 17737 SITE CLASS. PS DESIGN FLOW 240 L.T.A.R. 1.3

Septic Tank: 1000 Gallons; STB 1012 Date 3-8-97

Pump Tank: 1000 Gallons; PT 17 Date 4-24-97

Pump Make: Hydromatic Model 50 A1 Serial No. SHE 0A1

Nitrification Field: No Fields 1 Square Feet 630 Linear Feet 210

No Lines 3 Trench Width 36" Max Trench Bottom Depth 36" Gravel Depth N/A

☑ New System ☐ Repair System Type: I. II. III. IV. V. VI

System Description: Pump To Chambers

Repair System Description: " " Panels

Maintenance Agreement Required: ☐ Yes ☑ No

☑ House/Mod. Home No. Bedrooms 2

☐ Mobile Home No. Bathrooms 2

☐ Business No. Employees

☐ Other


☐ Slab ☐ Crawl Space ☑ Basement w/plumbing ☐ Basement wo/plumbing

Water Supply: ☐ Individual ☐ Community ☑ Public


Comments: See Attached Sheets for Pump Tank & Pressure Manifold set up

Comments: Checked Pump Draw Down manifold & Drain lines 6-11-97 JCM
Checked wiring 2-19-98 JCM

INITIAL SITE SKETCH

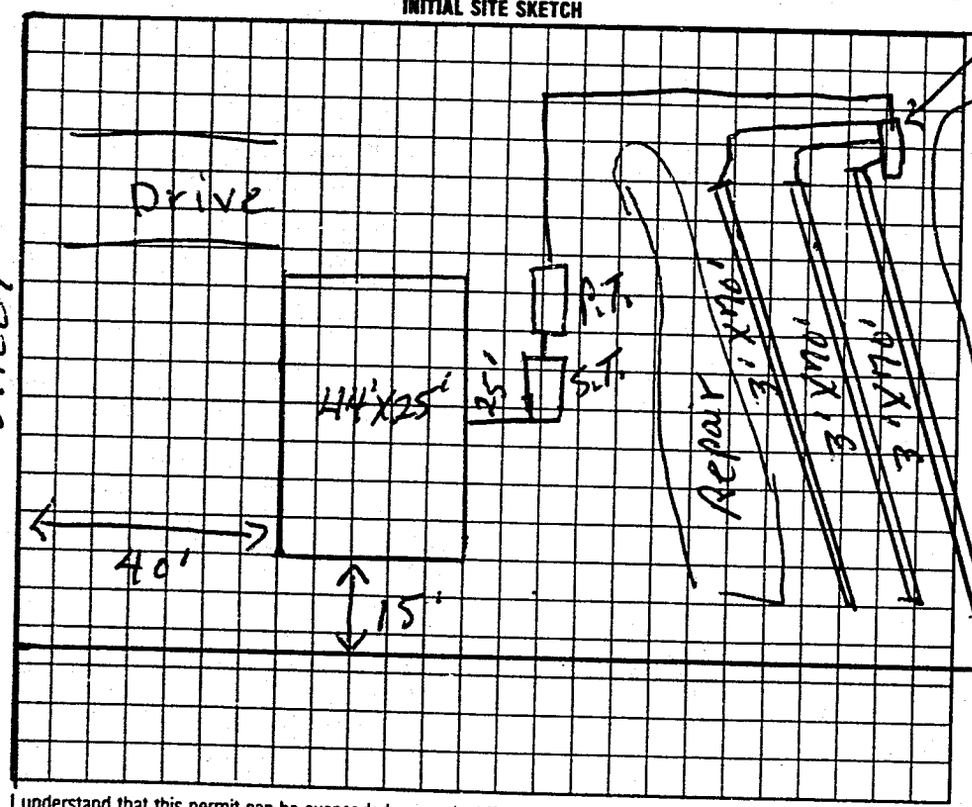

AS BUILT SKETCH

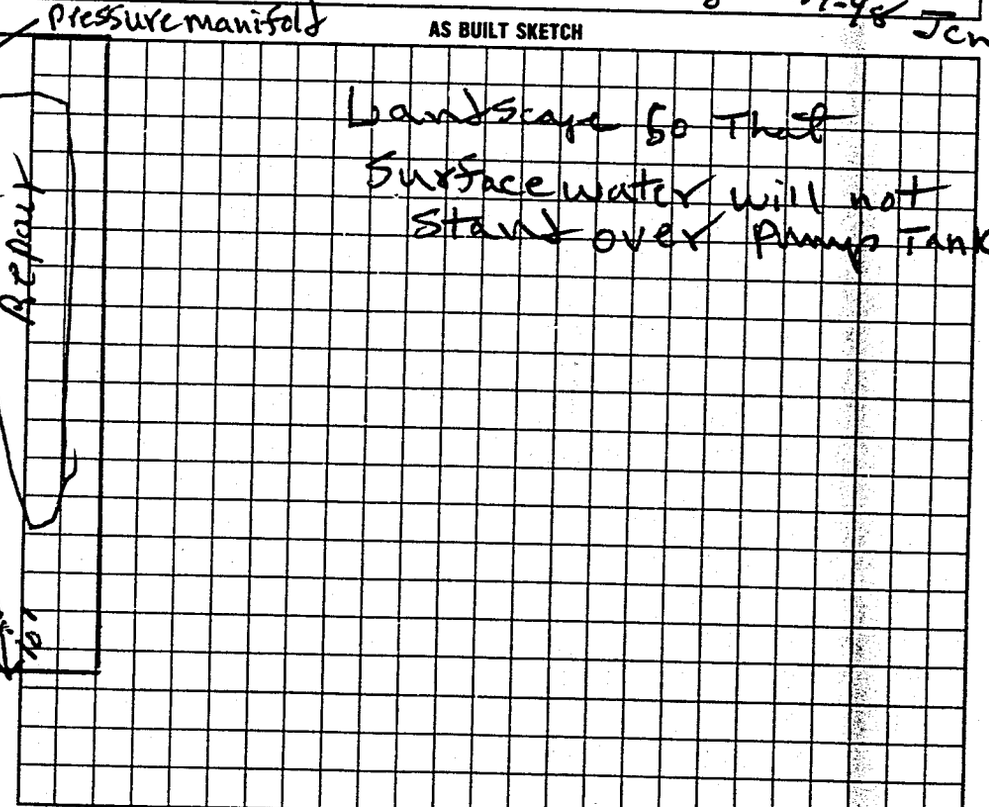

I understand that this permit can be suspended or revoked if any false information is supplied toward securing the permit/any unauthorized changes are made to the site/any unauthorized changes are made in the installation of the system.

Signed: Jody Hyatt

Improvement Permit by: R.C. moore date 7-11-96

Existing System Inspection by: R.C. moore date 7-11-96

Installed by: Arnie Duncan

Certificate of Completion by: date

Operation Permit by: R.C. moore date 2-19-98

Authorization To Count

To Count: Authorization to count Expires 60 mos from issue

HEALTH DEPT. COPY: WHITE INSPECTION COPY (FINAL): GREEN OWNER COPY (FINAL): YELLOW INSPECTION COPY (INITIAL): PINK OWNER COPY (INITIAL): GOLD