fd #150 MB

IREDELL COUNTY HEALTH DEPARTMENT

STATESVILLE 704-878-5305 MOORESVILLE 704-664-5281

IMPROVEMENT PERMIT / CERTIFICATE OF COMPLETION / OPERATION PERMIT / EXISTING SYSTEM INSPECTION

PROPERTY DESCRIPTION NO. 2429-20-6279.1 DATE 7-11-96 TAX MAP NO. 6E-17-A-40 Watershed: ☐ Yes ☐ No

OWNER OR CONTRACTOR Hope Bros Inc. PHONE: Business 872-4111 Home

ADDRESS 1120 Barkley Rd Statesville 28677

LOCATION Buffalo Shoals TR Airport TL Parker Lake TL Tower in curve

SUBDIVISION Lakewood Est BLOCK / SECTION II LOT 40 LOT AREA 15,294 SITE CLASS. PS DESIGN FLOW 360 L.T.A.R. .3

Septic Tank: 1000 Gallons; STB 1012 Date 2-19-97
Pump Tank: 1000 Gallons; PT 17 Date 11-30-96
Pump Make: Hydromatic Model SHEER Serial No. 2ME10
Nitrification Field: No Fields 1 Square Feet 900 Linear Feet 300
No Lines 4 Trench Width 36" Max Trench Bottom Depth 36" Gravel Depth N/A

☑ New System ☐ Repair System Type: I. II. III. IV. V. VI
System Description: Pump To chambers
Repair System Description: " " 6 Panels
Maintenance Agreement Required: ☐ Yes ☑ No


☑ House/Mod. Home No. Bedrooms 3
☐ Mobile Home No. Bathrooms 2
☐ Business No. Employees
☐ Other
☐ Slab ☐ Crawl Space ☑ Basement w/plumbing ☐ Basement wo/plumbing

Water Supply: ☐ Individual ☐ Community ☑ Public

Comments: See Attached Sheets for Pump Tank & pressure manifold setup


Comments: Check Drain lines 5-6-97 JCM
Pressure Tested Failed 5-6-97 JCM
Replaced Pump To 3/4 HP 6-11-97 JCM
Did not pressure Test will at later date

INITIAL SITE SKETCH

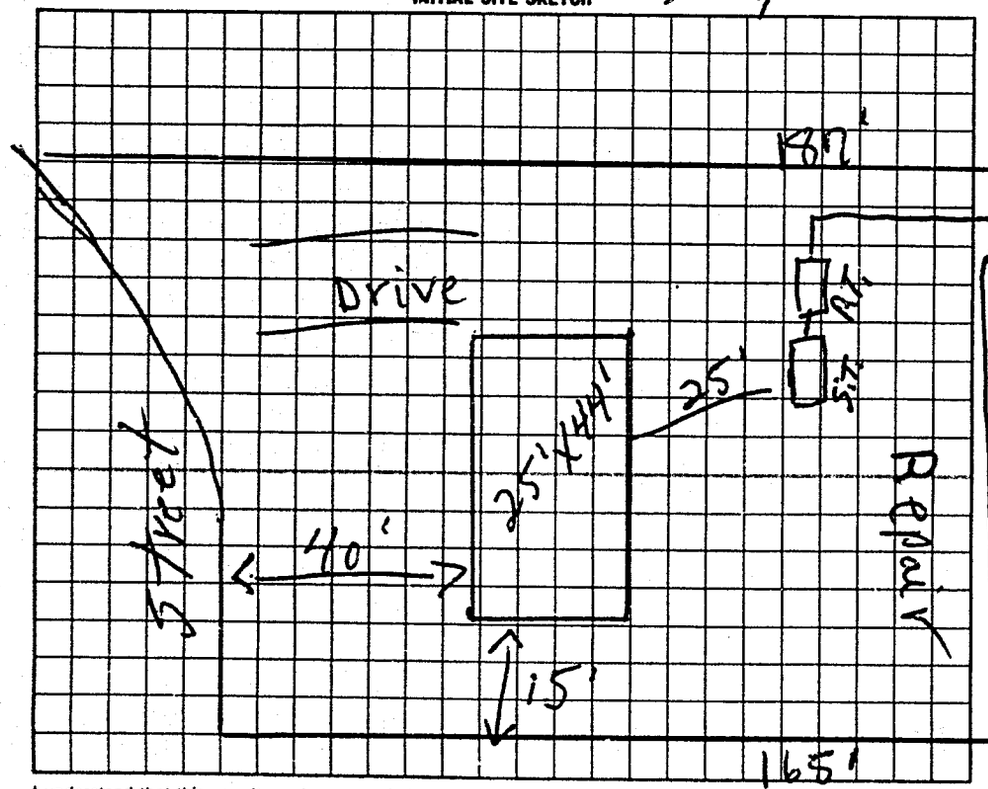

AS BUILT SKETCH

Final Check 4-24-98

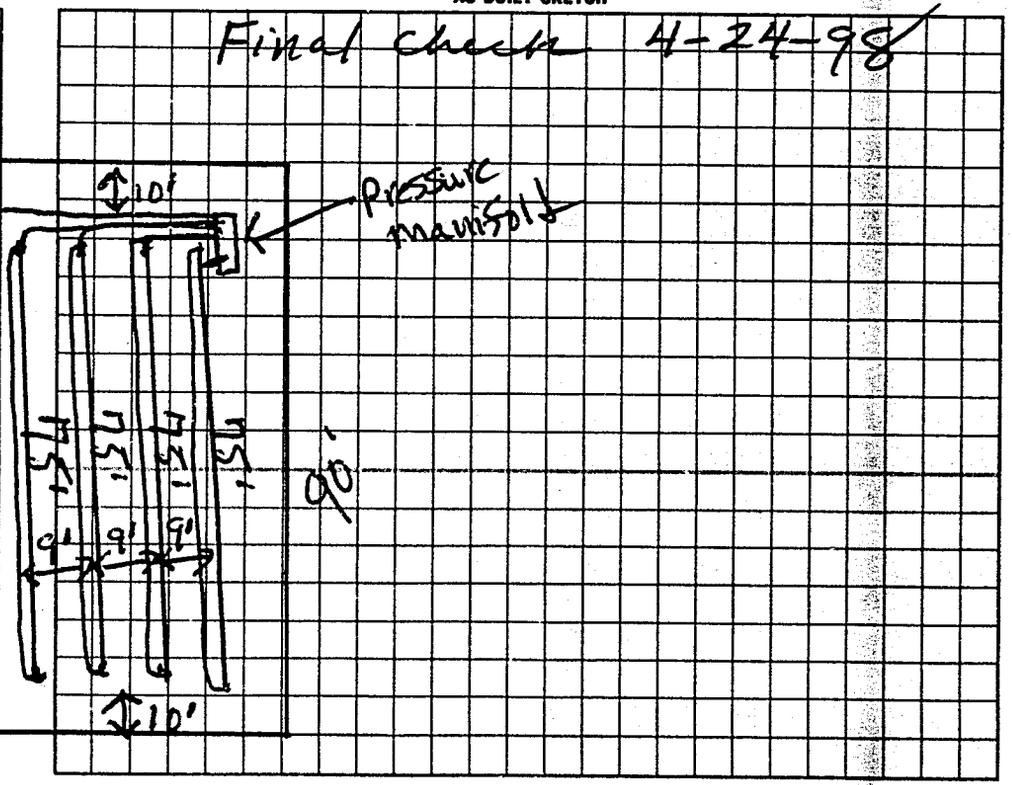

I understand that this permit can be suspended or revoked if any false information is supplied toward securing the permit/any unauthorized changes are made to the site/any unauthorized changes are made in the installation of the system.

Signed: John L Hyre, Jr

Improvement Permit by: C. C. Moore date 7-11-96

Existing System Inspection by: C. C. Moore date 7-11-96

Authorization to count

Installed by: Hope Bros

Certificate of Completion by: date

Operation Permit by: C. C. Moore date 4-24-98

HEALTH DEPT. COPY: WHITE INSPECTION COPY (FINAL): GREEN OWNER COPY (FINAL): YELLOW INSPECTION COPY (INITIAL): PINK OWNER COPY (INITIAL): GOLD

Authorization to count Expires 60 mos from issue