Rd #150 MB

9:30

# IREDELL COUNTY HEALTH DEPARTMENT

STATESVILLE 704-878-5305 MOORESVILLE 704-664-5281

## IMPROVEMENT PERMIT / CERTIFICATE OF COMPLETION / OPERATION PERMIT / EXISTING SYSTEM INSPECTION

PROPERTY DESCRIPTION NO. 24290 6627729 DATE 7-12-96 TAX MAP NO. 6E-17-A-96 Watershed: ☐ Yes ☑ No

OWNER OR CONTRACTOR Hope Bros Builders PHONE: Business 872-4111 Home

ADDRESS 1120 Barkley Road Statesville, N.C.

LOCATION Airport Rd/ Turn Parker Loop Rd, TL Tower 2nd Fromont on Rt

SUBDIVISION Lakewood est BLOCK / SECTION TL LOT 96 LOT AREA 15,611 sq' SITE CLASS. PS DESIGN FLOW 240 L.T.A.R. .13

Septic Tank: 1000 Gallons; STB 1012 Date 12-23-96

Pump Tank: 1000 Gallons; PT 117 Date 1-20-97

Pump Make: Hydromatic Model SHEF 50M Serial No. 5186470001

Nitrification Field: No Fields 1 Square Feet 630 Linear Feet 210

No Lines 3 Trench Width 36" Max Trench Bottom Depth 36"

☑ New System ☐ Repair System Type: I, II, III, IV, V, VI

System Description: Pump To Chambers

Repair System Description: " " Panels

Maintenance Agreement Required: ☐ Yes ☑ No

Gravel Depth N/A ☐ Slab ☐ Crawl Space ☑ Basement w/plumbing ☐ Basement wo/plumbing

☑ House/Mod. Home No. Bedrooms 2

☐ Mobile Home No. Bathrooms 2

☐ Business No. Employees

☐ Other

Water Supply: ☐ Individual ☐ Community ☑ Public


Comments:

See Attached Sheets for Pump Tank & Pressure manifold

Comments:

Check ST, PT, Drainlines 3-26-97 JCM

INITIAL SITE SKETCH

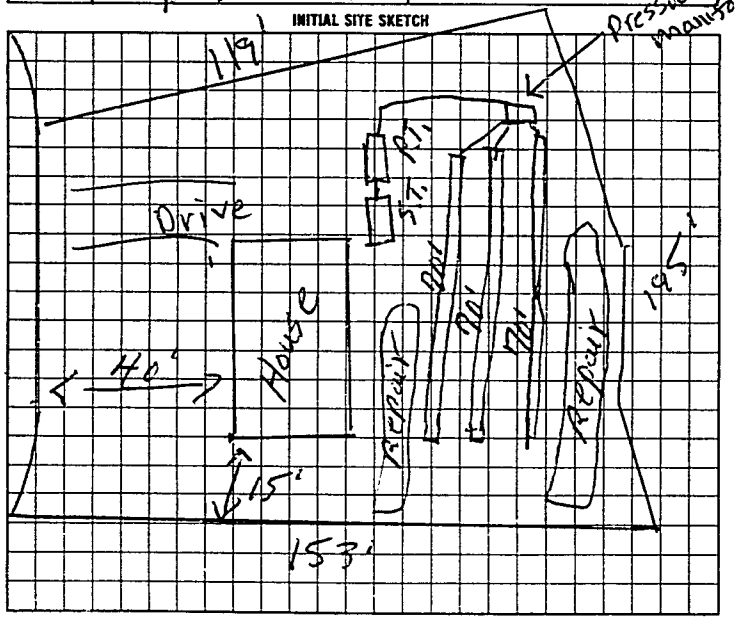


AS BUILT SKETCH

Checked Pump wiring & Box 11-3-97

Same as initial Sketch

I understand that this permit can be suspended or revoked if any false information is supplied toward securing the permit/any unauthorized changes are made to the site/any unauthorized changes are made in the installation of the system.

Signed: John L Hx-p

Improvement Permit by: P.C. moore date 7-12-96

Authorization Existing System Inspection by: P.C. moore date 7-12-96 to cont.

Installed by: Arnie Duncan

Certificate of Completion by: date

Operation Permit by P.C. moore date 11-3-97

HEALTH DEPT. COPY WHITE INSPECTION COPY (FINAL) GREEN OWNER COPY (FINAL) YELLOW INSPECTION COPY (INITIAL) PINK OWNER COPY (INITIAL) GOLD

Authorization to Count Expires 6 mos from issue