IREDELL COUNTY HEALTH DEPARTMENT

STATESVILLE 704-878-5305 MOORESVILLE 704-664-5281

IMPROVEMENT PERMIT / AUTHORIZATION TO CONSTRUCT / OPERATION PERMIT / EXISTING SYSTEM INSPECTION

PERMIT# REPAIR PIN# 4723-66-5463 DATE 4-14-04

OWNER OR CONTRACTOR JOHN HAMBLETT / CHRIS HARTSELL PHONE: Business _____ Home (704) 878-2477

ADDRESS 205 DELIGHT LOOP STATESVILLE 28677 / ONE NORMAN BLVD STE 220-110 CORNELIUS 28031

LOCATION BUFFALO SHOALS RD (R) AIRPORT (L) PARKER LAKE (L) DELIGHT 208 DELIGHT LOOP ON (L)

SUBDIVISION LAKEWOOD ESTS BLOCK / SECTION _____ LOT 98 LOT AREA ~0.6 SITE CLASS. PS DESIGN FLOW 360 L.T.A.R. EXISTING

Septic Tank: 1000 EXISTING Gallons; STB _____ Date _____

Pump Tank: _____ Gallons; PT _____ Date _____

Pump Make: _____ Model _____ Serial No. _____

Nitrification Field: No Fields 1 Square Feet ~~[illegible]~~ Linear Feet 240

No Lines 3 Trench Width 36" Max Trench Bottom Depth 36" Gravel Depth 12"

☐ New System ☑ Repair System Type: I (II) III, IV, V, VI

System Description: _____

Repair System Description: CONV. GRAVITY

Maintenance Agreement Required: ☐ Yes ☑ No

☑ House/Mod. Home ☐ Mobile Home ☐ Business ☐ Other

No. Bedrooms 3 No. Bathrooms 2 No. Employees _____

☐ Slab ☐ Crawl Space ☐ Basement w/plumbing ☐ Basement wo/plumbing


Water Supply: ☐ Individual ☑ Public ☐ Community

Comments/Conditions: (1) INSTALL LINES ON CONTOUR (2) MUST GRADE OFF BERM BEFORE SYSTEM IS INSTALLED TO HELP W/ SURFACE WATER PROBLEM (3) RECOMMEND SPLITTING UP LOADS OF CLOTHES DURING WEEK TO HELP ALLEVIATE WATER AMTS GOING INTO SYSTEM (4) THIS PERMIT IS A 30-DAY N.O.V. SITUATION MUST BE CORRECTED WITHIN 30 DAYS OR LEGAL ACTION WILL BE PURSUED W/O FURTHER NOTICE


Comments/Conditions: * System installed as shown.

SCALE 1" = 40'

INITIAL SITE SKETCH

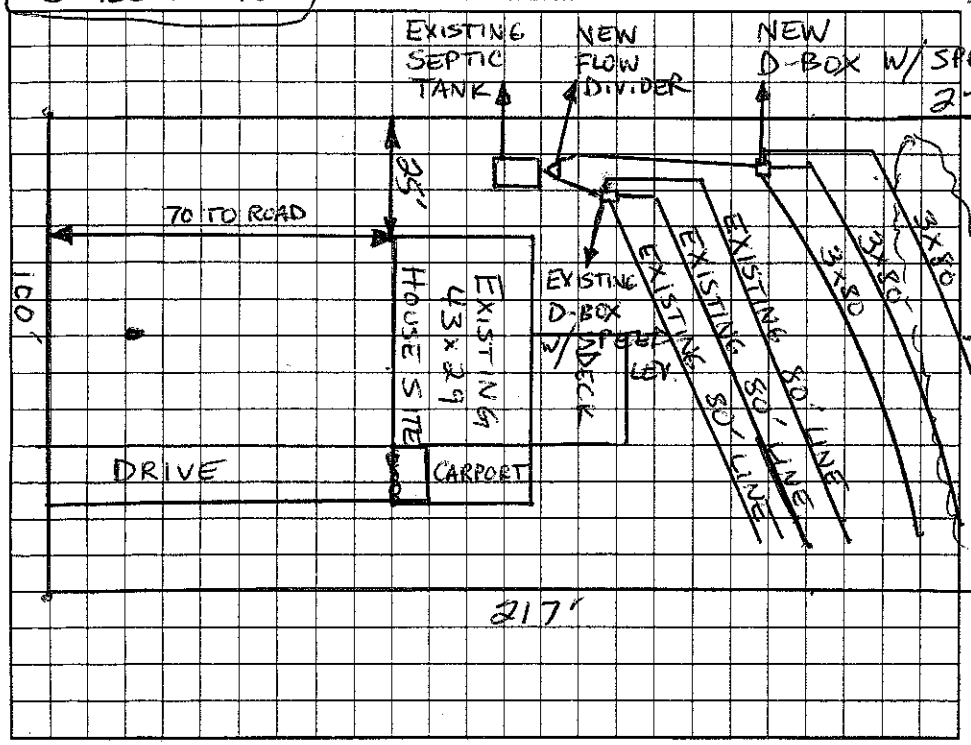

AS BUILT SKETCH

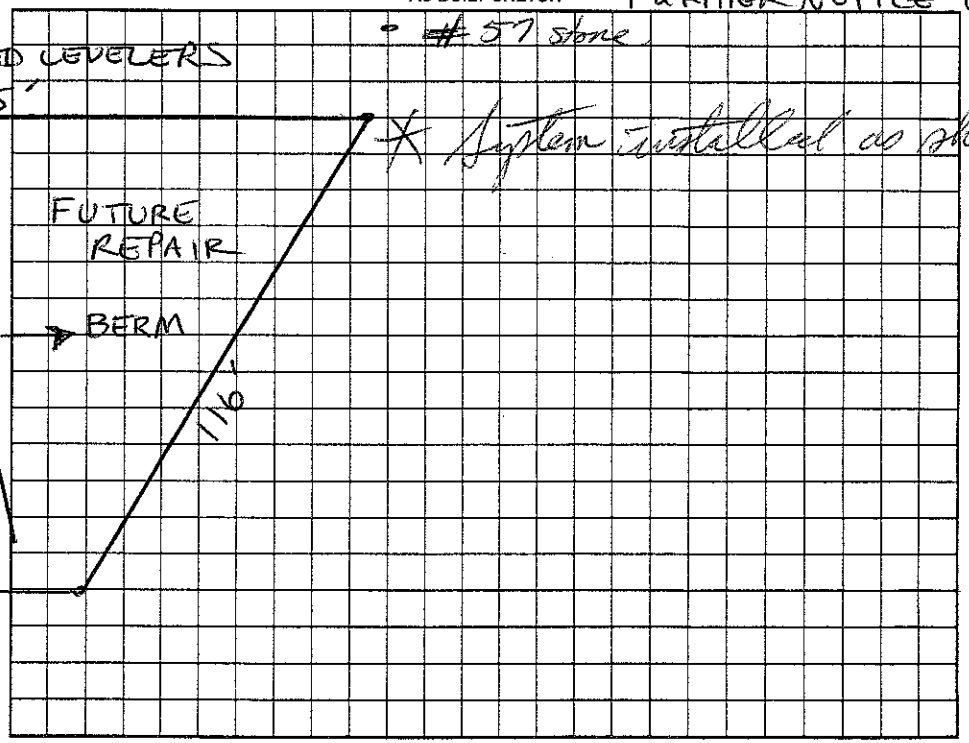

Permit can be suspended or revoked if any false information is supplied toward securing the permit/any unauthorized changes are made to the site/any unauthorized changes are made in the installation of the system. Improvement Permit with plat valid without expiration. Improvement Permit with site plan valid for sixty months. Authorization to Construct is valid for a period equal to that of Improvement Permit – not to exceed sixty months.

Signed: [signature] date 5/21/04 Installed by: James Hudler

Improvement Permit by: Christopher M. Sherrill, RS date 4-14-04 Operation Permit by: Christopher M. Sherrill, RS date 5-21-04

Authorization to Construct by: Christopher M. Sherrill, RS date 4-14-04 Existing System Inspection by: _____ date _____

HEALTH DEPT. COPY: WHITE OWNER COPY (FINAL): YELLOW OWNER COPY (INITIAL): PINK