49344

IREDELL COUNTY HEALTH DEPARTMENT

STATESVILLE 704-878-5305 MOORESVILLE 704-664-5281

IMPROVEMENT PERMIT / CERTIFICATE OF COMPLETION / OPERATION PERMIT / EXISTING SYSTEM INSPECTION

PROPERTY DESCRIPTION NO. 17365 DATE 11-4-93 TAX MAP NO. 6E-16-A-84

OWNER OR CONTRACTOR Hope Bros. Watershed: ☐ Yes ☑ No

ADDRESS 1120 Barkley Rd. Statesville, N.C. 28677 PHONE: Business 872-4111 Home

LOCATION I40W TL Stamey Farm Rd. TL Hwy 70 TR Airport Rd TR Parker Lake Loop TL Delight Loop. Lot on L

SUBDIVISION Lakewood Est. BLOCK / SECTION LOT 84 LOT AREA 100' x 150' SITE CLASS. P.S. DESIGN FLOW 360 L.T.A.R. .35 gpd/ft²

Septic Tank: 1000 Gallons; STB 358 Date 11-27-93

Pump Tank: — Gallons; PT — Date —

Pump Make: — Model — Serial No. —

Nitrification Field: No Fields 1 Square Feet 1035 Linear Feet 345

No Lines 5 Trench Width 36" Max Trench Bottom Depth 36" Gravel Depth 12"

☑ New System ☐ Repair System Type: I, (II), III, IV, V, VI

System Description: Conventional, gravity

Repair System Description: gravity PPBPS

Maintenance Agreement Required: ☐ Yes ☑ No

☑ House/Mod. Home No. Bedrooms 3

☐ Mobile Home No. Bathrooms 2

☐ Business No. Employees —

☐ Other


☐ Slab ☑ Crawl Space ☐ Basement w/plumbing ☐ Basement wo/plumbing

Water Supply: ☐ Individual ☐ Community ☑ Public


Comments: Install system as shallow as possible (no deeper than 36" to trench bottom) keep Nitrification lines on contour. Keep system 10' from all property lines, 5' from foundation of home, and 10' from all water lines. 100% Repair in front yard, gravity PPBPS.

Comments: System left uncovered (open) to rough weather (periods of rain + ice) this may affect life of system. 100% Repair in front yard, PPBPS, gravity fed.

INITIAL SITE SKETCH

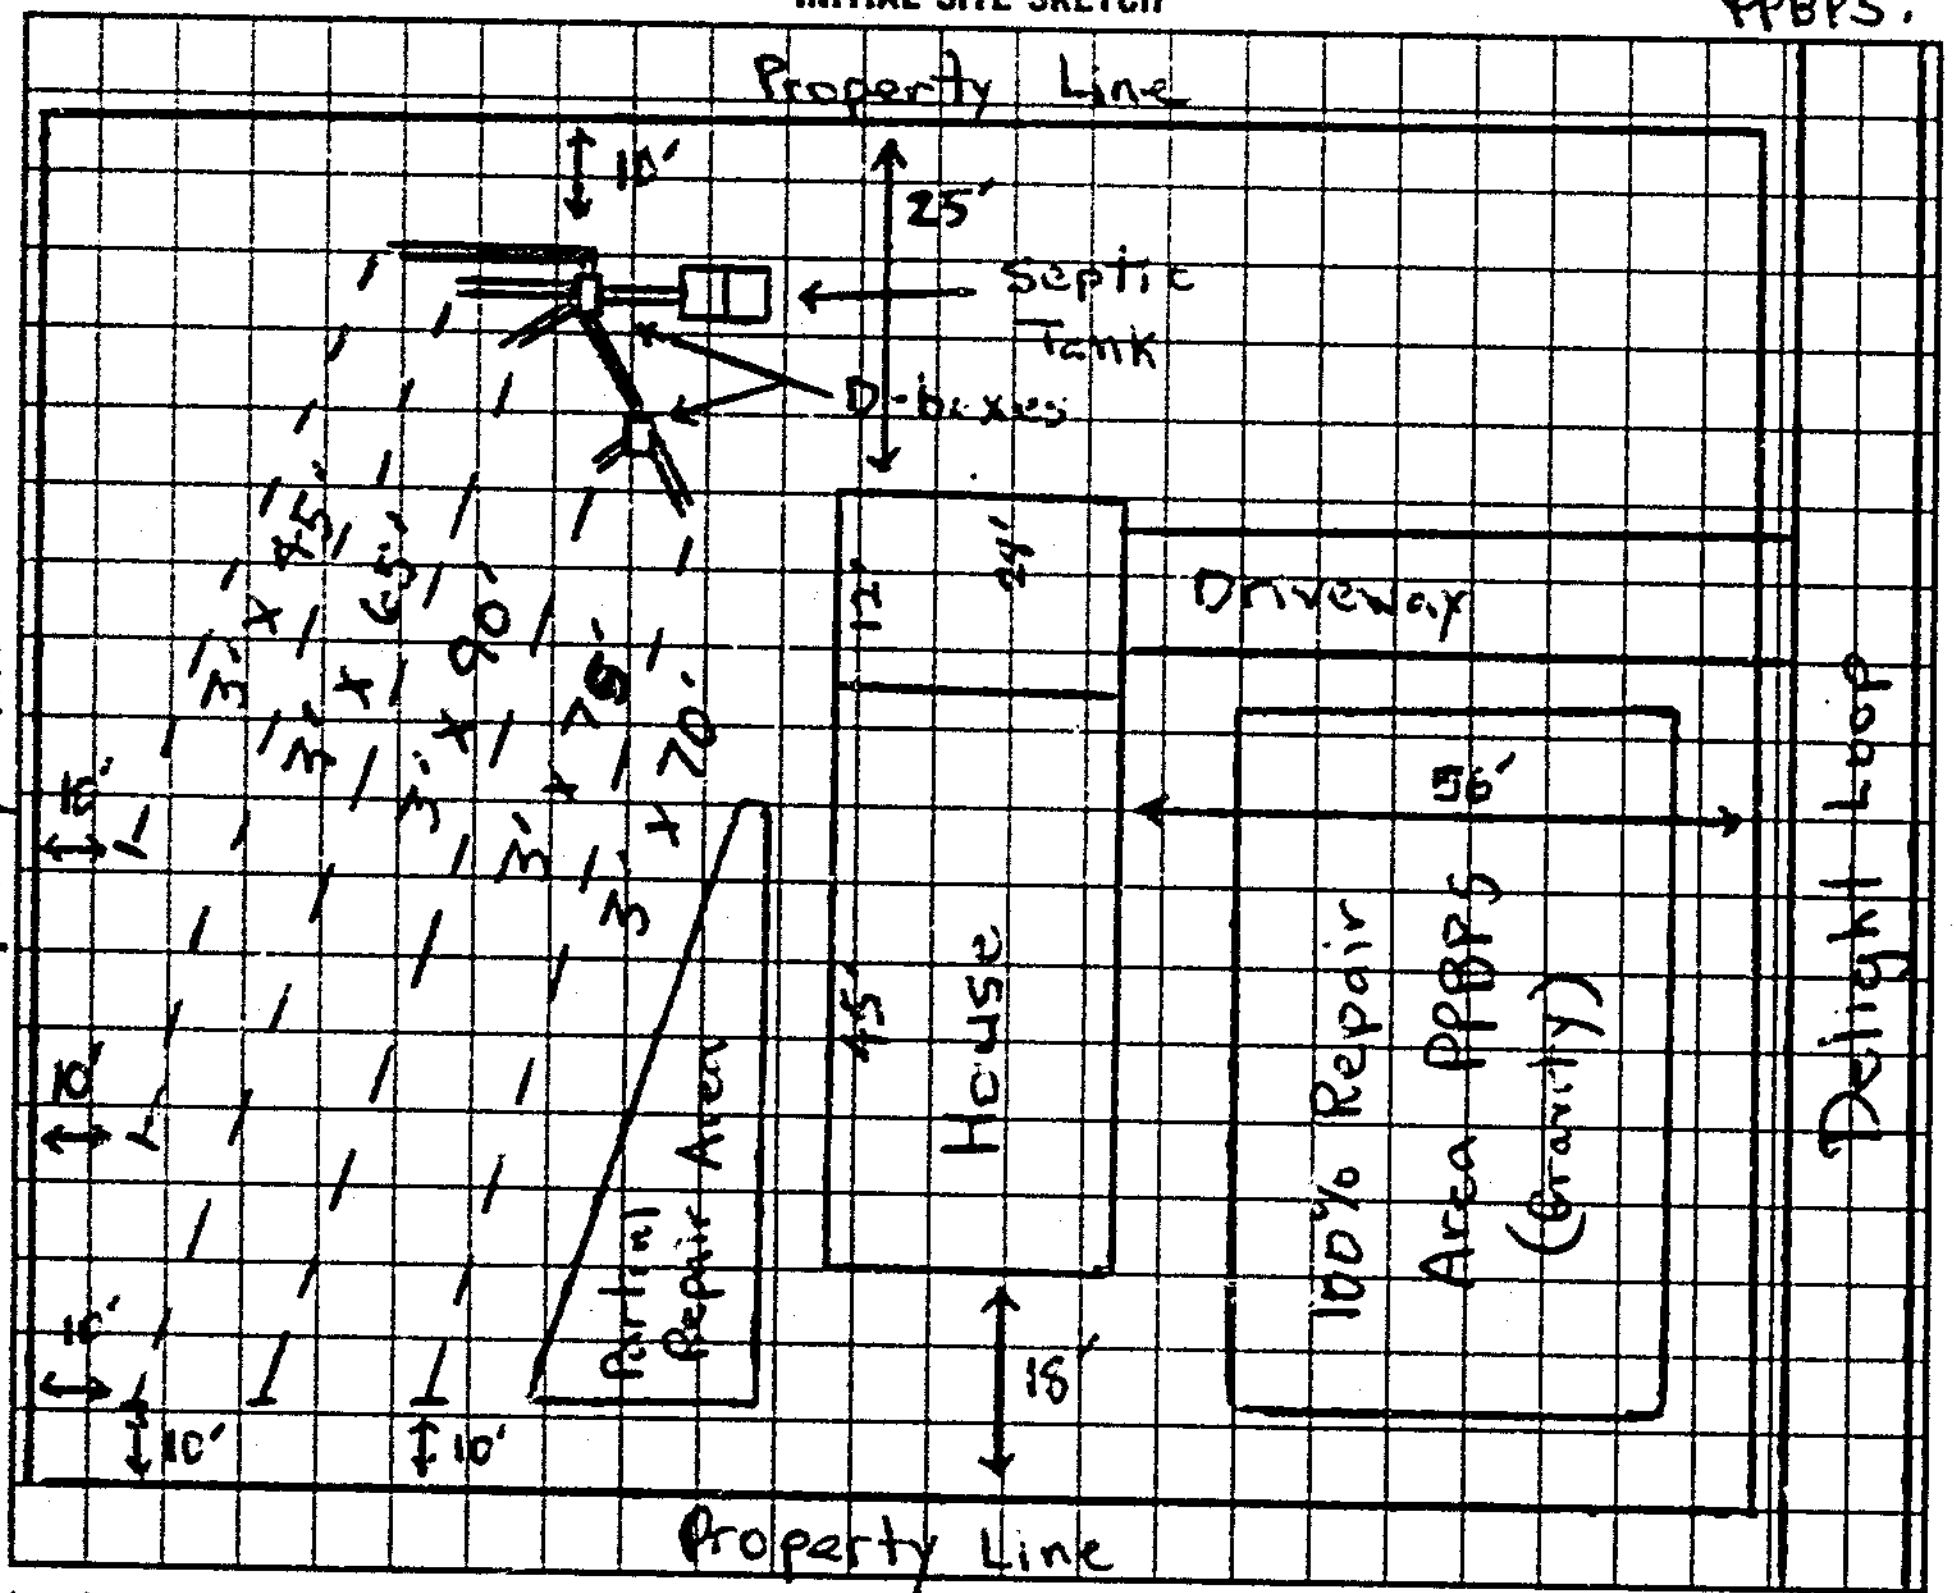

AS BUILT SKETCH

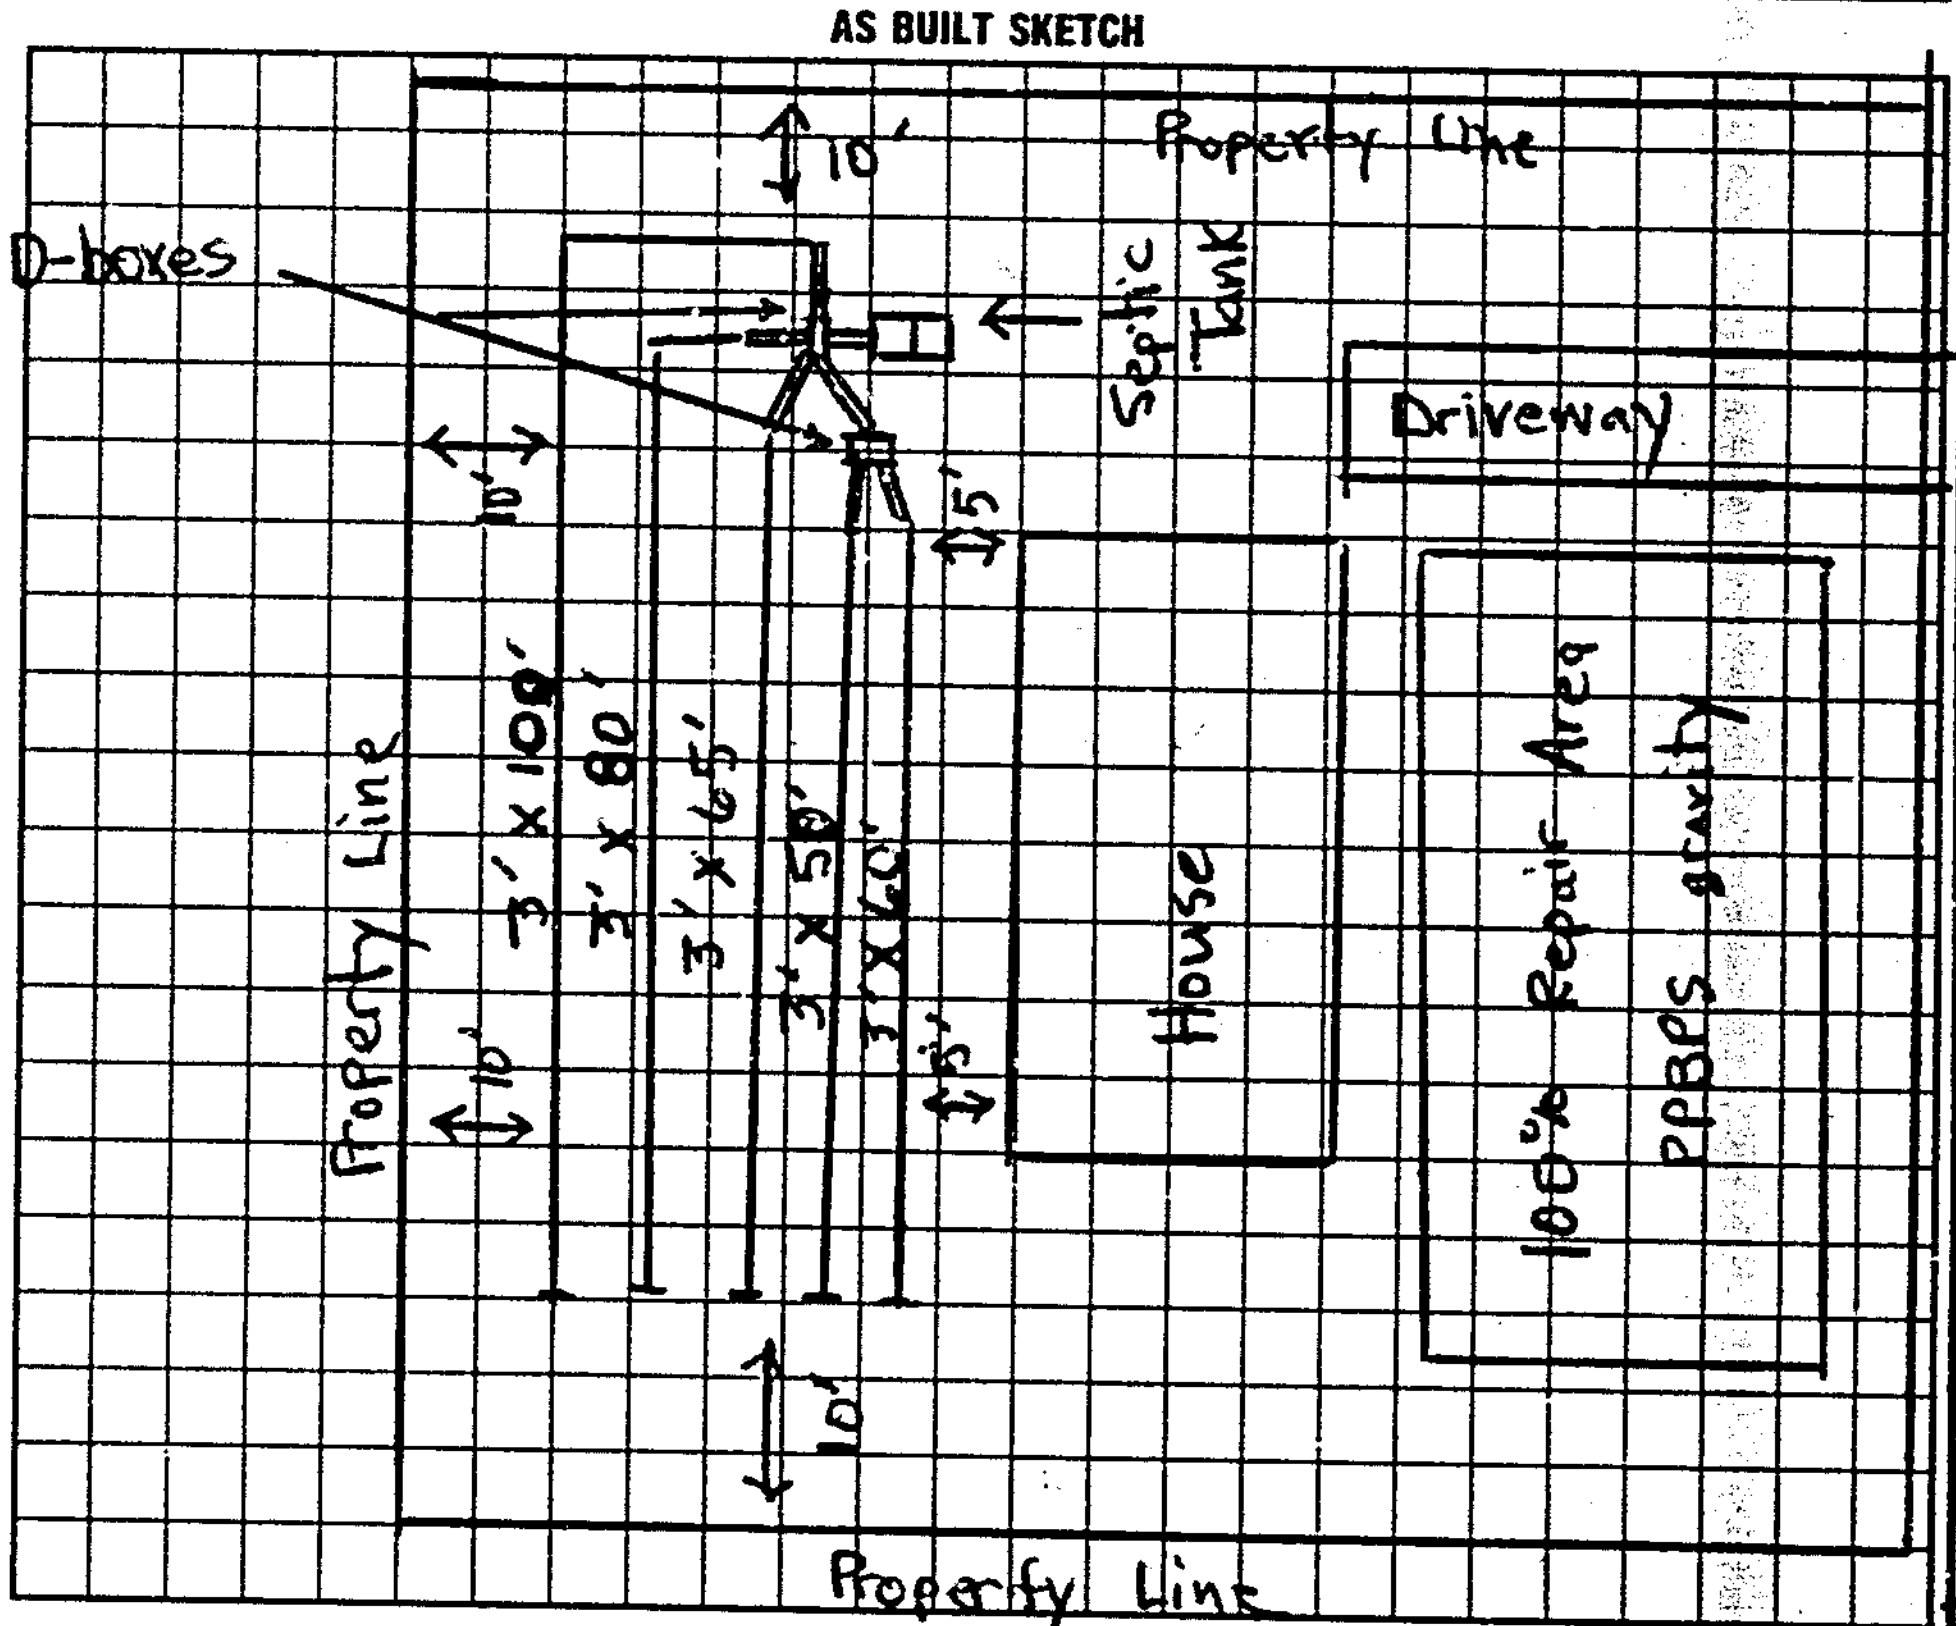

I understand that this permit can be suspended or revoked if any false information is supplied toward securing the permit/any unauthorized changes are made to the site/any unauthorized changes are made in the installation of the system. Improvement Permit is valid for 60 months from date of issuance.

Signed: Arno Duncan

Improvement Permit by: Michael J. Dennis date 11-4-93

Existing System Inspection by: date

Installed by: Hope Bros.

Certificate of Completion by: Michael J. Dennis date 1-25-94

Operation Permit by: date

HEALTH DEPT. COPY: WHITE INSPECTION COPY (FINAL): GREEN OWNER COPY (FINAL): YELLOW INSPECTION COPY (INITIAL): PINK OWNER COPY (INITIAL): GOLD