IREDELL COUNTY HEALTH DEPARTMENT

STATESVILLE 704-878-5305 MOORESVILLE 704-664-5281

IMPROVEMENT PERMIT / AUTHORIZATION TO CONSTRUCT / OPERATION PERMIT / EXISTING SYSTEM INSPECTION

PERMIT# 84118 PIN# 4723667496 DATE 10-12-99

OWNER OR CONTRACTOR Hope Brothers PHONE: Business 872 4111 Home

ADDRESS 1120 Barkley Rd Statesville, N.C.

LOCATION Buffalo Shoals / TR Airport Rd TL Parkinlake TL Delight on left (196 Delight loop

SUBDIVISION Lakewood Est BLOCK / SECTION LOT 100 LOT AREA .44acres SITE CLASS PS DESIGN FLOW 360 L.T.A.R. .3

Septic Tank: 1000 Gallons; STB 1012 Date 10-15-00
Pump Tank: Gallons; PT Date
Pump Make: Model Serial No.
Nitrification Field: No Fields 1 Square Feet 900 Linear Feet 300
No Lines 3 Trench Width 36" Max Trench Bottom Depth 36" Gravel Depth N/A

☑ New System ☐ Repair System Type: I, II, III, IV, V, VI
System Description: Gravity/25% Reduct,
Repair System Description: " " "
Maintenance Agreement Required: ☐ Yes ☑ No

☑ House/Mod. Home No. Bedrooms 3
☐ Mobile Home No. Bathrooms 2
☐ Business No. Employees
☐ Other


☐ Slab ☐ Crawl Space ☐ Basement w/plumbing ☐ Basement wo/plumbing

Water Supply: ☐ Individual ☑ Public ☐ Community


Comments/Conditions:

Comments/Conditions: - Septic Tank Marker Installed
- Poly Lok Filter Installed
- Installed 50 Infiltrator Chambers

INITIAL SITE SKETCH

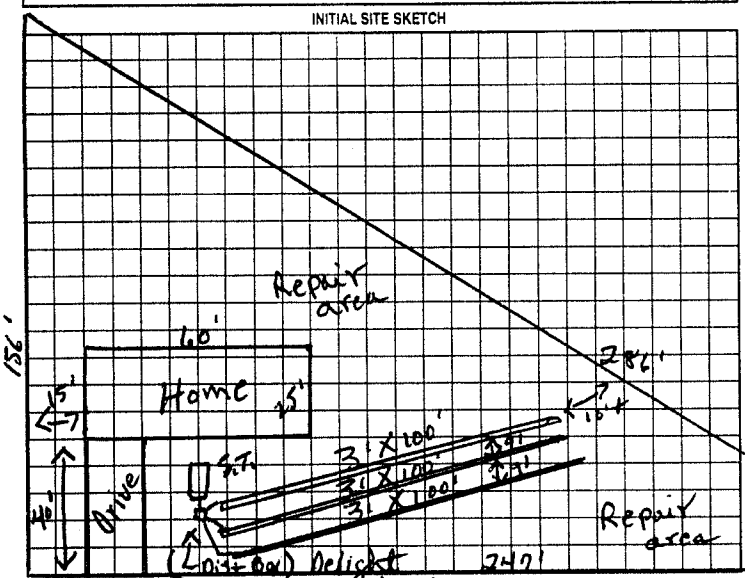

AS BUILT SKETCH

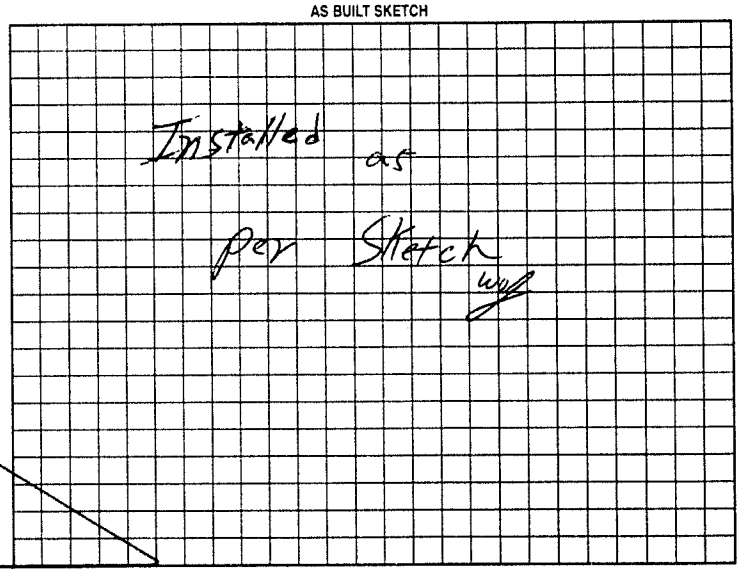

Permit can be suspended or revoked if any false information is supplied toward securing the permit/any unauthorized changes are made to the site/any unauthorized changes are made in the installation of the system. Improvement Permit with plat valid without expiration. Improvement Permit with site plan valid for sixty months. Authorization to Construct is valid for a period equal to that of Improvement Permit – not to exceed sixty months.

Signed: John L Hope, Jr date 10-15-99 Installed by: Hope Brothers

Improvement Permit by: R. C. Moore date 10-12-99 Operation Permit by: William T. Johnson date 3/19/01

Authorization to Construct by: R. C. Moore date 10/2-99 Existing System Inspection by: date

HEALTH DEPT. COPY: WHITE OWNER COPY (FINAL): YELLOW OWNER COPY (INITIAL): PINK