49281

IREDELL COUNTY HEALTH DEPARTMENT

STATESVILLE 704-878-5305 MOORESVILLE 704-664-5281

IMPROVEMENT PERMIT / CERTIFICATE OF COMPLETION / OPERATION PERMIT / EXISTING SYSTEM INSPECTION

PROPERTY DESCRIPTION NO. 17366 DATE 11-4-93 TAX MAP NO. GE-17-A-85 Watershed: ☐ Yes ☑ No

OWNER OR CONTRACTOR Hope Bros. PHONE: Business Home 872-4111

ADDRESS 1120 Barkley Rd. Statesville, N.C. 28677

LOCATION I40W TL Stamey Farm Rd TL Hwy 70 TR Airport Rd. TR Parker Lake Loop. TL Delight Loop Lot on L.

SUBDIVISION Lakewood Est. BLOCK / SECTION LOT 85 LOT AREA 100' X 150' SITE CLASS. P.S. DESIGN FLOW 360 L.T.A.R. .35 gpd/ft²

Septic Tank: 1000 Gallons; STB 358 Date 11-29-93
Pump Tank: — Gallons; PT — Date —
Pump Make: — Model — Serial No. —
Nitrification Field: No Fields 1 Square Feet 1035 Linear Feet 345'
No Lines 4 Trench Width 36" Max Trench Bottom Depth 36" Gravel Depth 12"

☑ New System ☐ Repair System Type: I (II) III, IV, V, VI
System Description: Conventional / gravity
Repair System Description: gravity PPBPS
Maintenance Agreement Required: ☐ Yes ☑ No

☑ House/Mod. Home No. Bedrooms 3
☐ Mobile Home No. Bathrooms 2
☐ Business No. Employees —
☐ Other


☐ Slab ☑ Crawl Space ☐ Basement w/plumbing ☐ Basement wo/plumbing

Water Supply: ☐ Individual ☐ Community ☑ Public


Comments: Install system as shallow as possible, no deeper than 36" to trench bottom. Keep Nitrification Lines on Contour. Keep System 5' from foundation of home, 10' from all property lines, and 10' from water line, 100% Repair Area in front yard, gravity PPBPS.

Comments: System not installed the way it was permitted, not on contour. System approved due to lack of available space. 100% Repair in front yard, PPBPS, gravity fed.

INITIAL SITE SKETCH

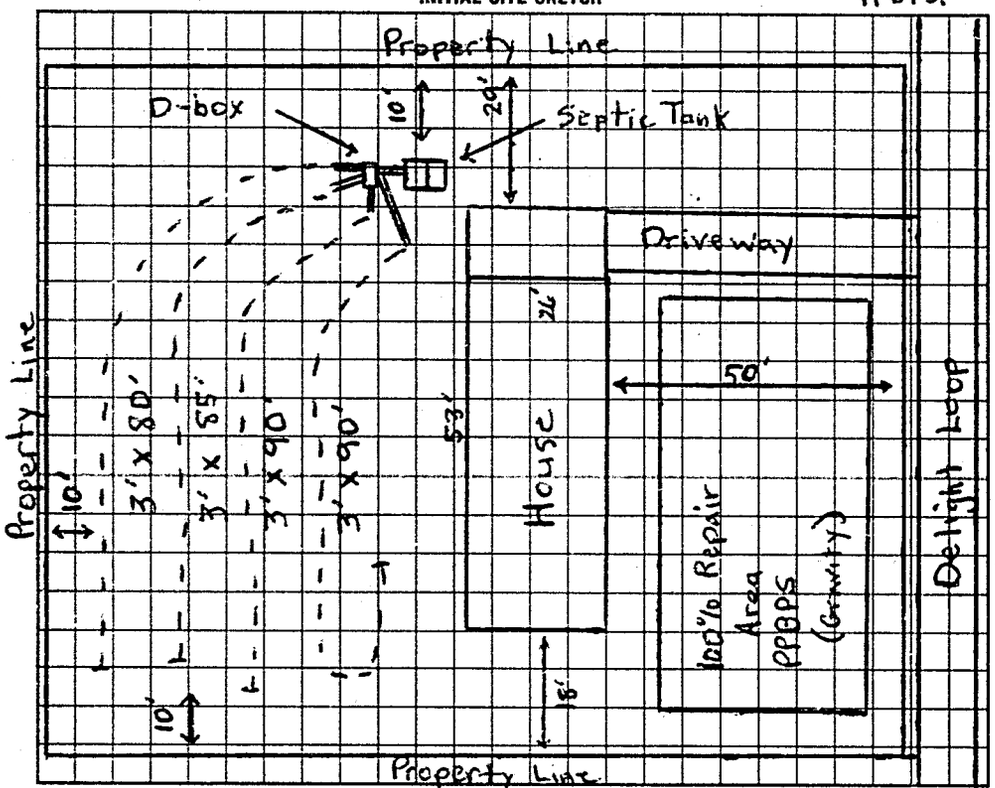

AS BUILT SKETCH

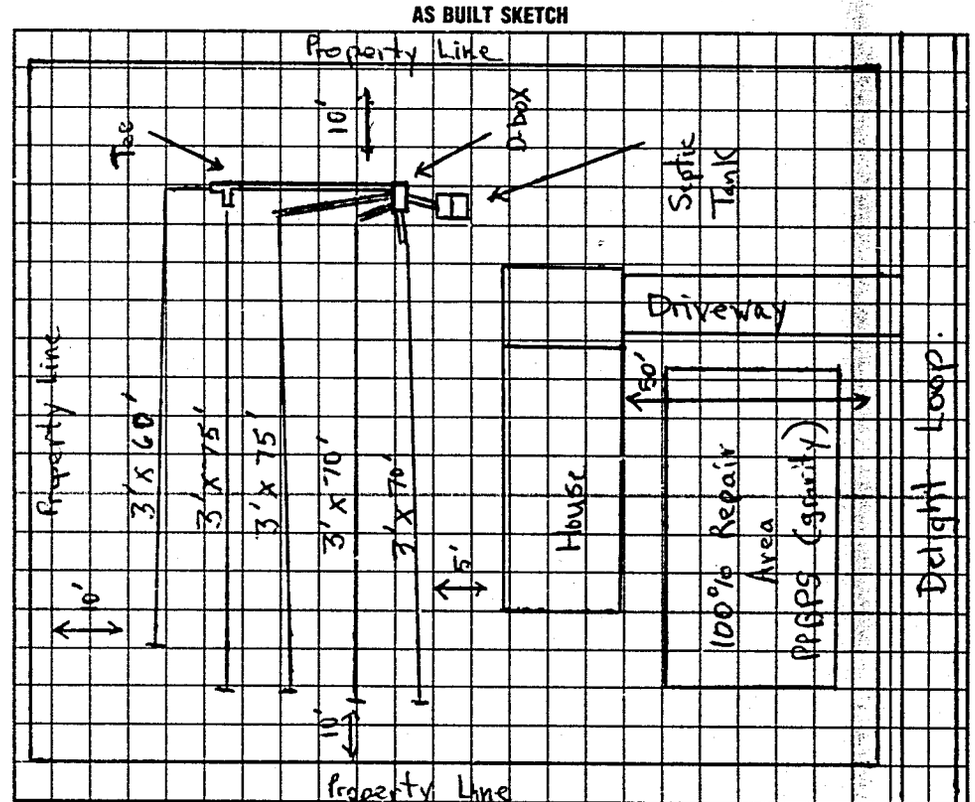

I understand that this permit can be suspended or revoked if any false information is supplied toward securing the permit/any unauthorized changes are made to the site/any unauthorized changes are made in the installation of the system. Improvement Permit is valid for 60 months from date of issuance.

Signed: James Duncan

Improvement Permit by: Michael Q. Dennis date 11-4-93

Existing System Inspection by: date

Installed by: Hope Bros.

Certificate of Completion by: Michael Q. Dennis date 5-10-94

Operation Permit by: date

HEALTH DEPT. COPY: WHITE INSPECTION COPY (FINAL): GREEN OWNER COPY (FINAL): YELLOW INSPECTION COPY (INITIAL): PINK OWNER COPY (INITIAL): GOLD