IREDELL COUNTY HEALTH DEPARTMENT

STATESVILLE 704-878-5305 MOORESVILLE 704-664-5281

IMPROVEMENT PERMIT / CERTIFICATE OF COMPLETION / OPERATION PERMIT / EXISTING SYSTEM INSPECTION

PROPERTY DESCRIPTION NO. 68703 DATE 7-24-97 TAX MAP NO. 6Z-17-A-66 Watershed: ☐ Yes ☐ No

OWNER OR CONTRACTOR Tim Hamby PHONE: Business _____ Home 872 0825

ADDRESS 906 Old Mocksville Rd Sta N.C.

LOCATION NOW TO Airport Rd TR 2nd Ent: Parker Lake TO Delight Loop 1/4m Rt

SUBDIVISION Lakewood BLOCK / SECTION _____ LOT 66 LOT AREA 1/2 acre SITE CLASS. PS DESIGN FLOW 360 L.T.A.R. .3

Septic Tank: 1000 Gallons; STB 1012 Date 7-4-97

Pump Tank: _____ Gallons; PT _____ Date _____

Pump Make: _____ Model _____ Serial No. _____

Nitrification Field: No Fields 1 Square Feet 1200 Linear Feet 400

No Lines 5 Trench Width 36" Max Trench Bottom Depth 36" Gravel Depth 12"

☑ New System ☐ Repair System Type: I ☑ II, III, IV, V, VI

System Description: Conv. Gravity

Repair System Description: Pump to chamber

Maintenance Agreement Required: ☐ Yes ☑ No

☑ House/Mod. Home No. Bedrooms 3

☐ Mobile Home No. Bathrooms 2

☐ Business No. Employees _____

☐ Other _____

☑ Slab ☐ Crawl Space ☐ Basement w/plumbing ☐ Basement wo/plumbing


Water Supply: ☐ Individual ☐ Community ☑ Public

Comments:


200'

Comments:

INITIAL SITE SKETCH

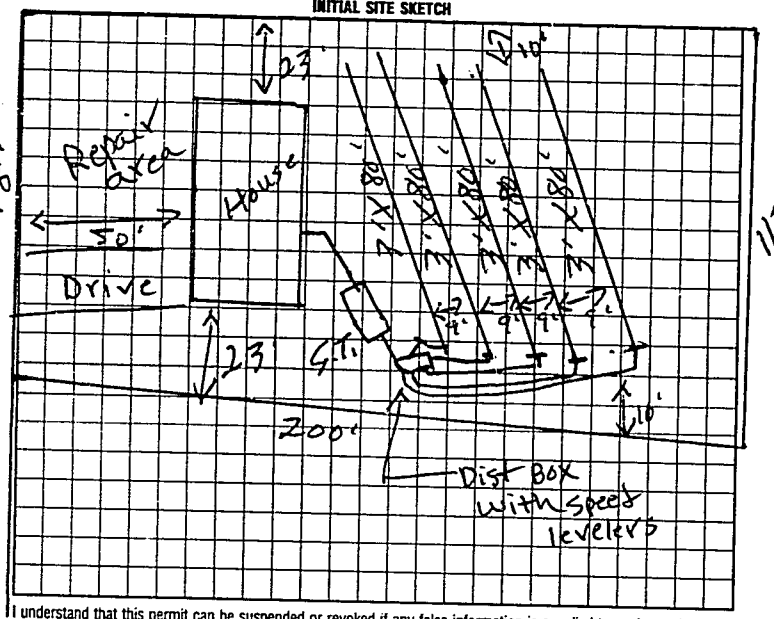

AS BUILT SKETCH

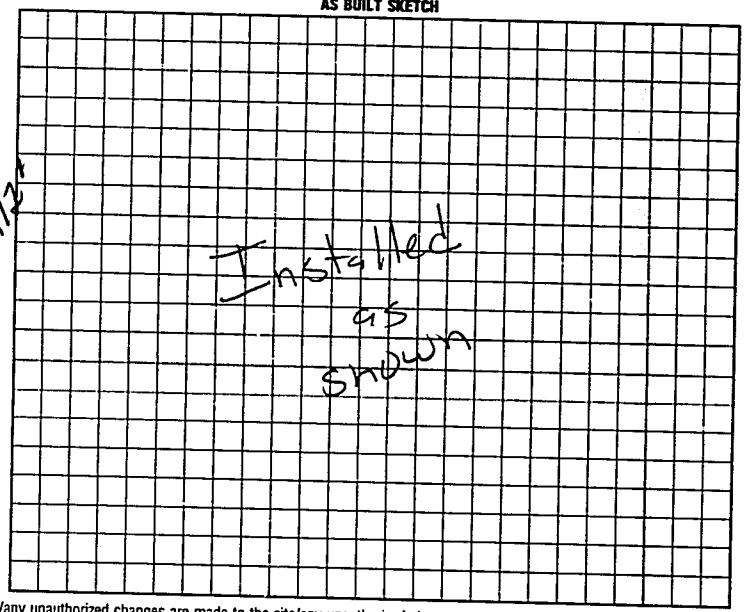

I understand that this permit can be suspended or revoked if any false information is supplied toward securing the permit/any unauthorized changes are made to the site/any unauthorized changes are made in the installation of the system. Improvement Permit is valid for 60 months from date of issuance.

Signed: X Tim Hamby

Improvement Permit by: B.C. Moore date 7-24-97

Existing System Inspection Authorization B.C. Moore date 7-24-97 to cont.

Installed by: A-1

Certificate of Completion by: _____ date _____

Operation Permit by: Mark COJ RS date 10-17-97

HEALTH DEPT COPY: WHITE INSPECTION COPY (FINAL): GREEN OWNER COPY (FINAL): YELLOW INSPECTION COPY (INITIAL): PINK OWNER COPY (INITIAL): GOLD

Authorization to cont. Expires 60 mos from issue

E 160000