pd 7/75 2693

IREDELL COUNTY HEALTH DEPARTMENT

STATESVILLE 704-878-5305 MOORESVILLE 704-664-5281

IMPROVEMENT PERMIT / AUTHORIZATION TO CONSTRUCT / OPERATION PERMIT / EXISTING SYSTEM INSPECTION

PERMIT# 2-1426 072687 PIN# 4723 66 9377 DATE 1-29-98

OWNER OR CONTRACTOR Hope Brother's PHONE: Business 872 4111 Home

ADDRESS 1120 Barkley Rd Statesville, N.C.

LOCATION 195 Delight Loop 70 West TL, Airport TR Parker Loop TL (2nd) Delight Loop lot on R

SUBDIVISION Lakewood BLOCK / SECTION LOT 67 LOT AREA 100' X 200' SITE CLASS PS DESIGN FLOW 360 L.T.A.R. 1.3

Septic Tank: 1000 Gallons; STB 1012 Date 2-27-98

Pump Tank: Gallons; PT Date

Pump Make: Model 900 Serial No. 300

Nitrification Field: No Fields 1 Square Feet 1200 Linear Feet 400

No Lines 4 Trench Width 36" Max Trench Bottom Depth 36" Gravel Depth N/A

☑ New System ☐ Repair System Type: I, II, III, IV, V, VI

System Description: Gravity/Chamber or Hip

Repair System Description:

Maintenance Agreement Required: ☐ Yes ☑ No

☑ House/Mod. Home ☐ Mobile Home ☐ Business ☐ Other

No. Bedrooms 3 No. Bathrooms 2 No. Employees


☐ Slab ☑ Crawl Space ☐ Basement w/plumbing ☐ Basement wo/plumbing

Water Supply: ☐ Individual ☑ Public ☐ Community


Comments:/Conditions:

Comments:/Conditions:

INITIAL SITE SKETCH

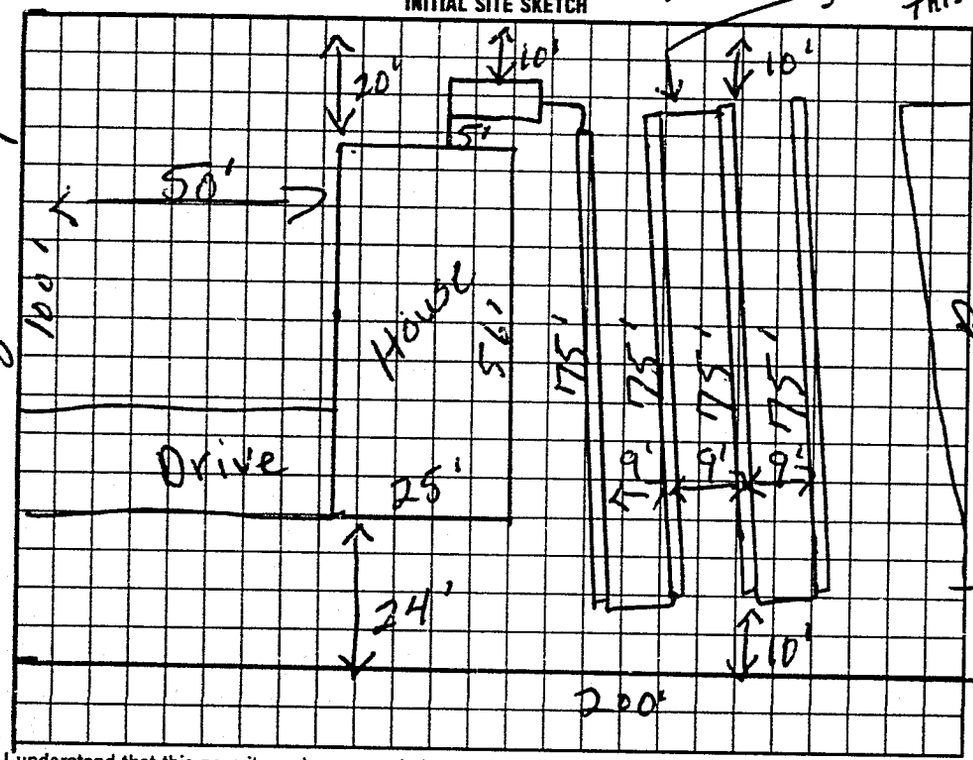

AS BUILT SKETCH

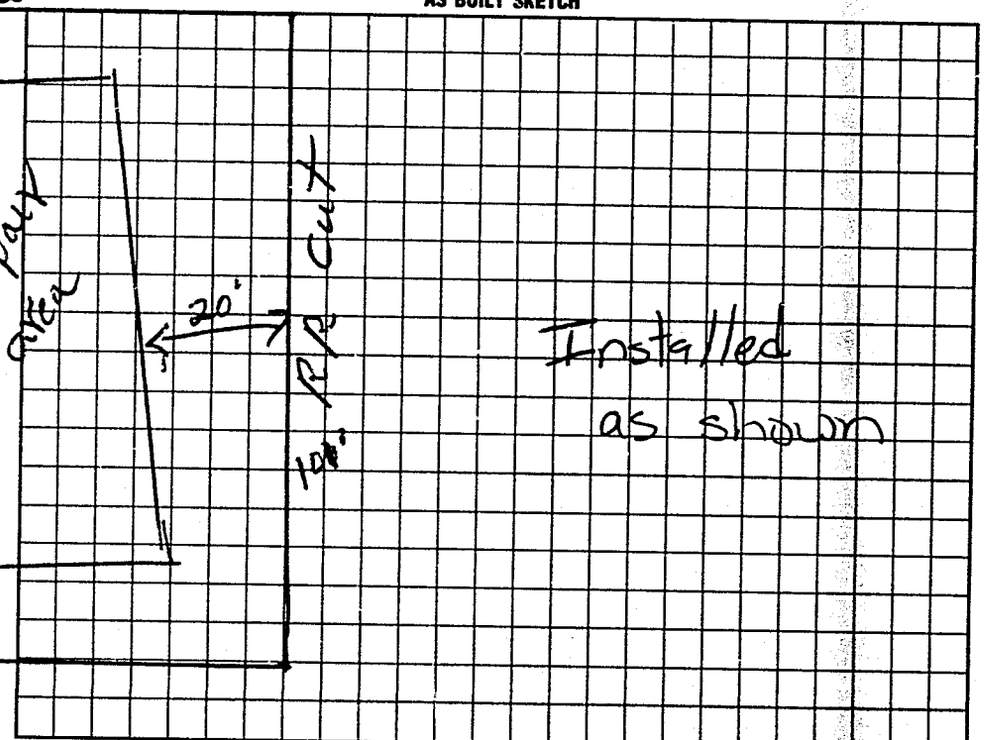

I understand that this permit can be suspended or revoked if any false information is supplied toward securing the permit/any unauthorized changes are made to the site/any unauthorized changes are made in the installation of the system. Improvement Permit with plat valid without expiration. Improvement Permit with site plan valid for sixty months. Authorization to Construct is valid for a period equal to that of Improvement Permit – not to exceed sixty months.

Signed: John A Hix

Improvement Permit by: E. C. Moore date 1-29-98

Authorization to Construct by: E. C. Moore date 1-29-98

Installed by: Forest Shuford

Operation Permit by: Mary Cutts date 5-6-98

Existing System Inspection by: date

HEALTH DEPT. COPY: WHITE INSPECTION COPY (FINAL): GREEN OWNER COPY (FINAL): YELLOW INSPECTION COPY (INITIAL): PINK OWNER COPY (INITIAL): GOLD