IREDELL COUNTY HEALTH DEPARTMENT

STATESVILLE 704-878-5305 MOORESVILLE 704-664-5281

47074

IMPROVEMENT PERMIT / CERTIFICATE OF COMPLETION / OPERATION PERMIT / EXISTING SYSTEM INSPECTION

PROPERTY DESCRIPTION NO. 16240 DATE 10-19-93 TAX MAP NO. 6E-17-A-87

OWNER OR CONTRACTOR Hope Bros. Builders. PHONE: Business Home 872-4111

ADDRESS

LOCATION I-40 W TL Stamey Farm Rd. TL Hwy 70 TR Air Port Rd. TR Parker Lake Loop Rd TL Lakewood Dr. Lot on L

SUBDIVISION Lakewood Est. BLOCK / SECTION LOT 87 LOT AREA 100' X 150' SITE CLASS. P.S. DESIGN FLOW 360 L.T.A.R. .375 gpd/ft²

Watershed: ☐ Yes ☑ No

Septic Tank: 1000 Gallons; STB 358 Date 9-15-93

Pump Tank: — Gallons; PT — Date —

Pump Make: — Model — Serial No. —

Nitrification Field: No Fields 1 Square Feet 960 Linear Feet 320'

No Lines 4 Trench Width 36" Max Trench Bottom Depth 18"-36" Gravel Depth 12"

☑ New System ☐ Repair System Type: I, II, III, IV, V, VI

System Description: Conventional gravity

Repair System Description: PPBPS

Maintenance Agreement Required: ☐ Yes ☑ No

☑ House/Mod. Home ☐ Mobile Home ☐ Business ☐ Other

No. Bedrooms 3 No. Bathrooms 2 No. Employees


☐ Slab ☑ Crawl Space ☐ Basement w/plumbing ☐ Basement wo/plumbing

Water Supply: ☐ Individual ☐ Community ☑ Public


Comments: This Permit void permit issued 4-27-93. Keep system as shallow as possible. Keep lines on contour Keep system min. 5' from foundation of home, 10' from property line and 10' from water line. 100% Repair below system and in front of home, PPBPS.

Comments:

INITIAL SITE SKETCH Keep tank as shallow as possible (no deeper than 10" to bp.)

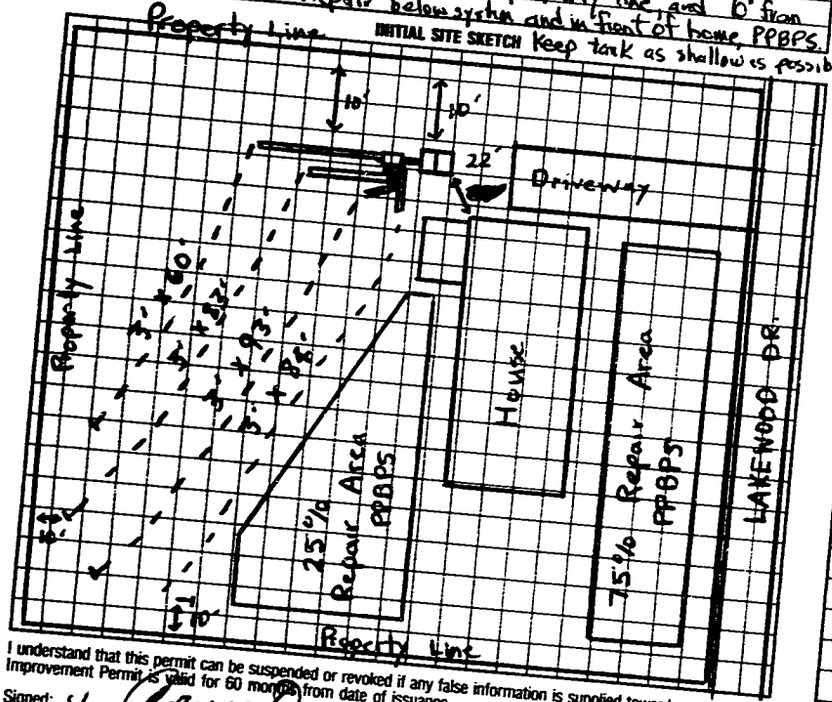

AS BUILT SKETCH

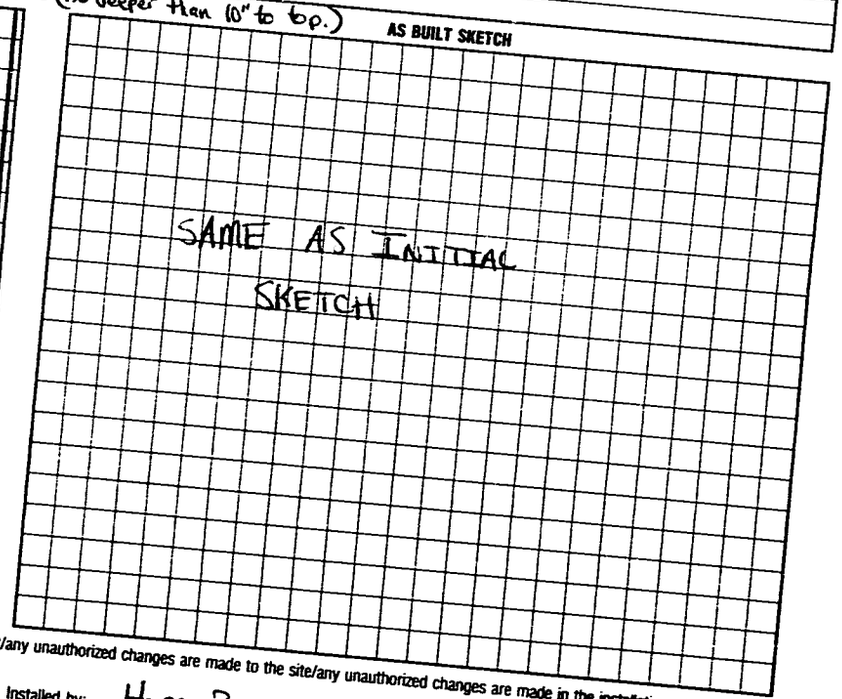

I understand that this permit can be suspended or revoked if any false information is supplied toward securing the permit/any unauthorized changes are made to the site/any unauthorized changes are made in the installation of the system. Improvement Permit is valid for 60 months from date of issuance.

Signed: [signature]

Improvement Permit by: Michael A. Dennis R.S. C. Moore date 10-19-93

Existing System Inspection by: date

Installed by: Hope Bros.

Certificate of Completion by: Michael A. Dennis

Operation Permit by: date 10-25-93

date

HEALTH DEPT. COPY: WHITE INSPECTION COPY (FINAL): GREEN OWNER COPY (FINAL): YELLOW INSPECTION COPY (INITIAL): PINK OWNER COPY (INITIAL): GOLD