IREDELL COUNTY HEALTH DEPARTMENT

STATESVILLE 704-878-5305 MOORESVILLE 704-664-5281

IMPROVEMENT PERMIT / AUTHORIZATION TO CONSTRUCT / OPERATION PERMIT / EXISTING SYSTEM INSPECTION

PERMIT# RELOCATION PIN# 4723-68-8659 DATE 10-19-01

OWNER OR CONTRACTOR GREGG BRYAN PHONE: Business Home (704)

ADDRESS 359 CORNELIUS ROAD, MOORESVILLE, NC 28117

LOCATION US 70 WEST, TL AIRPORT ROAD, EXISTING HOUSE ON LEFT AT BOX # 493 ~ 0.7 MILES

SUBDIVISION BLOCK / SECTION LOT LOT AREA 53.4 ACRES SITE CLASS PS DESIGN FLOW 480 L.T.A.R. 0.30 GPD/FT²

Septic Tank: 1000 Gallons: STB 1012 Date 9-8-01

Pump Tank: Gallons: PT Date

Pump Make: Model Serial No

Nitrification Field: No Fields 1 Square Feet 1600 Linear Feet 533+

No Lines SIX Trench Width 36" Max Trench Bottom Depth 36" Gravel Depth 12"

☑ New System ☐ Repair System Type: I (II) III IV V VI

System Description: CONVENTIONAL GRAVITY

Repair System Description: -

Maintenance Agreement Required: ☐ Yes ☑ No

☑ House/Mod Home ☐ Mobile Home ☐ Business ☐ Other

No. Bedrooms 4 No. Bathrooms 2 No. Employees


☐ Slab ☑ Crawl Space ☐ Basement w/plumbing ☐ Basement wo/plumbing

Water Supply: ☐ Individual ☑ Public ☐ Community ☑ WELL

Comments/Conditions: (1) ABANDON EXISTING SYSTEM, INSTALL NEW SEPTIC TANK & DRAINFIELD AS SHOWN & FLAGGED ON SITE (2) USE ONE FLOW DIVIDER TEE TO ACHIEVE EQUAL DIST. FEEDING THREE LINES EACH.

Comments/Conditions: SEPTIC TANK WITH MARKER INSTALLED USING "PolyLok" FILTER

INITIAL SITE SKETCH

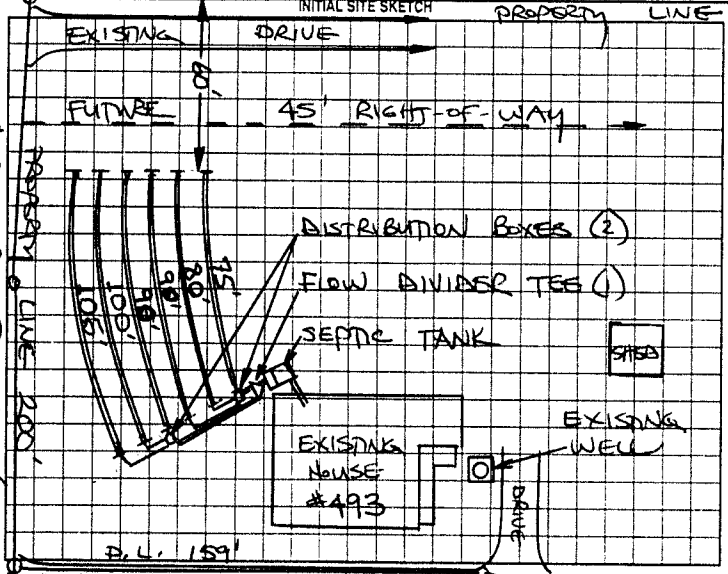

AS BUILT SKETCH

SYSTEM RELOCATED ACCORDING TO INITIAL SITE SKETCH

Permit can be suspended or revoked if any false information is supplied toward securing the permit, any unauthorized changes are made to the site, any unauthorized changes are made in the installation of the system. Improvement Permit with plat valid without expiration. Improvement Permit with site plan valid for sixty months. Authorization to Construct is valid for a period equal to that of Improvement Permit – not to exceed sixty months.

Signed: X [signature] date 10-19-01 Installed by: STEVE JORDAN

Improvement Permit by: STEVE HENDRICK date 10-19-01 Operation Permit by: STEVE HENDRICK date 11-20-01

Authorization to Construct by: STEVE HENDRICK date 10-19-01 Existing System Inspection by: date

HEALTH DEPT COPY WHITE OWNER COPY (FINAL) YELLOW OWNER COPY (INITIAL) PINK