IREDELL COUNTY HEALTH DEPARTMENT

STATESVILLE 704-878-5305 MOORESVILLE 704-664-5281

IMPROVEMENT PERMIT / AUTHORIZATION TO CONSTRUCT / OPERATION PERMIT / EXISTING SYSTEM INSPECTION

PERMIT# 72587 PIN# 4723680776 DATE Nov 8 99

OWNER OR CONTRACTOR David Thomas Moose PHONE: Business 873 2746 Home

ADDRESS 455 Airport Rd Statesville, NC

LOCATION Buffalo Shoals ~~Road~~ (R) Airport Rd 1/4 mile on Right

SUBDIVISION BLOCK / SECTION LOT LOT AREA 3.3 Ac SITE CLASS. PS DESIGN FLOW 110 L.T.A.R. .3

Septic Tank: 1000 Gallons; STB 1012 Date 8 27 99
Pump Tank: Gallons; PT Date
Pump Make: Model Serial No.
Nitrification Field: No Fields 1 Square Feet 360 Linear Feet 120
No Lines 2 @ 60' Trench Width 36" Max Trench Bottom Depth 36"

☒ New System ☐ Repair System Type: I, II, III, IV, V, VI
System Description: Conv Gravity
Repair System Description: Same
Maintenance Agreement Required: ☐ Yes ☒ No

☐ House/Mod. Home No. Bedrooms
☐ Mobile Home No. Bathrooms
☒ Business No. Employees 4
☐ Other


Water Supply: ☐ Individual ☒ Public ☐ Community

Gravel Depth 12" ☒ Slab ☐ Crawl Space ☐ Basement w/plumbing ☐ Basement wo/plumbing


Comments:/Conditions: Install on Contour
Storage Building 4 employees Max.

Comments:/Conditions:

INITIAL SITE SKETCH

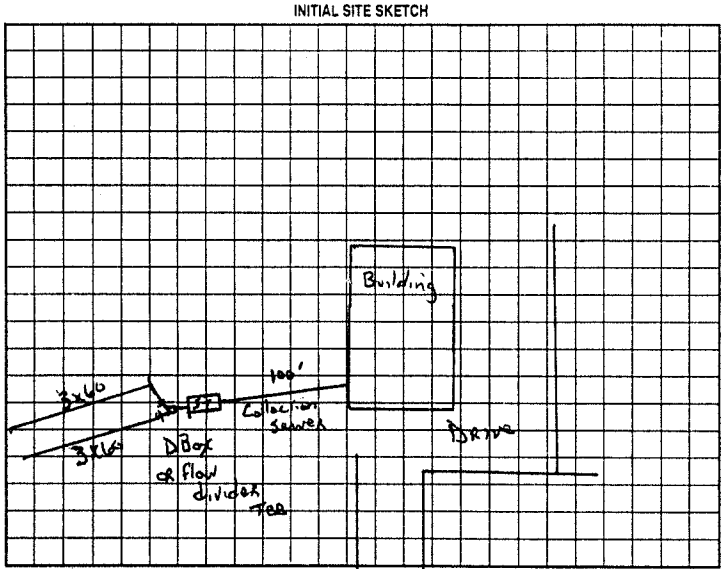

AS BUILT SKETCH

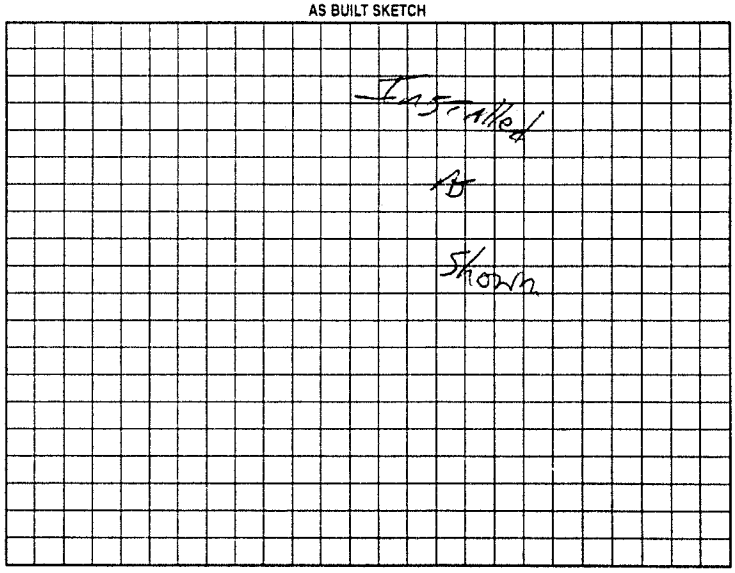

Permit can be suspended or revoked if any false information is supplied toward securing the permit/any unauthorized changes are made to the site/any unauthorized changes are made in the installation of the system. Improvement Permit with plat valid without expiration. Improvement Permit with site plan valid for sixty months. Authorization to Construct is valid for a period equal to that of Improvement Permit – not to exceed sixty months.

Signed: David T. Moose date 11/8/99

Improvement Permit by: Joyce Potter date Nov 8 99

Authorization to Construct by: Joyce Potter date Nov 8 99

Installed by: Young & Son

Operation Permit by: Joyce Potter date Nov 10 99

Existing System Inspection by: date

HEALTH DEPT COPY: WHITE OWNER COPY (FINAL): YELLOW OWNER COPY (INITIAL): PINK